


REVISIONS					
CHK DATE	CHK BY	DESCRIPTION	DATE	BY	REV
8/15/24	JAB	UPDATED FRONT SLIDEOUT SEAT LAYOUT	8/15/24	CJM	02

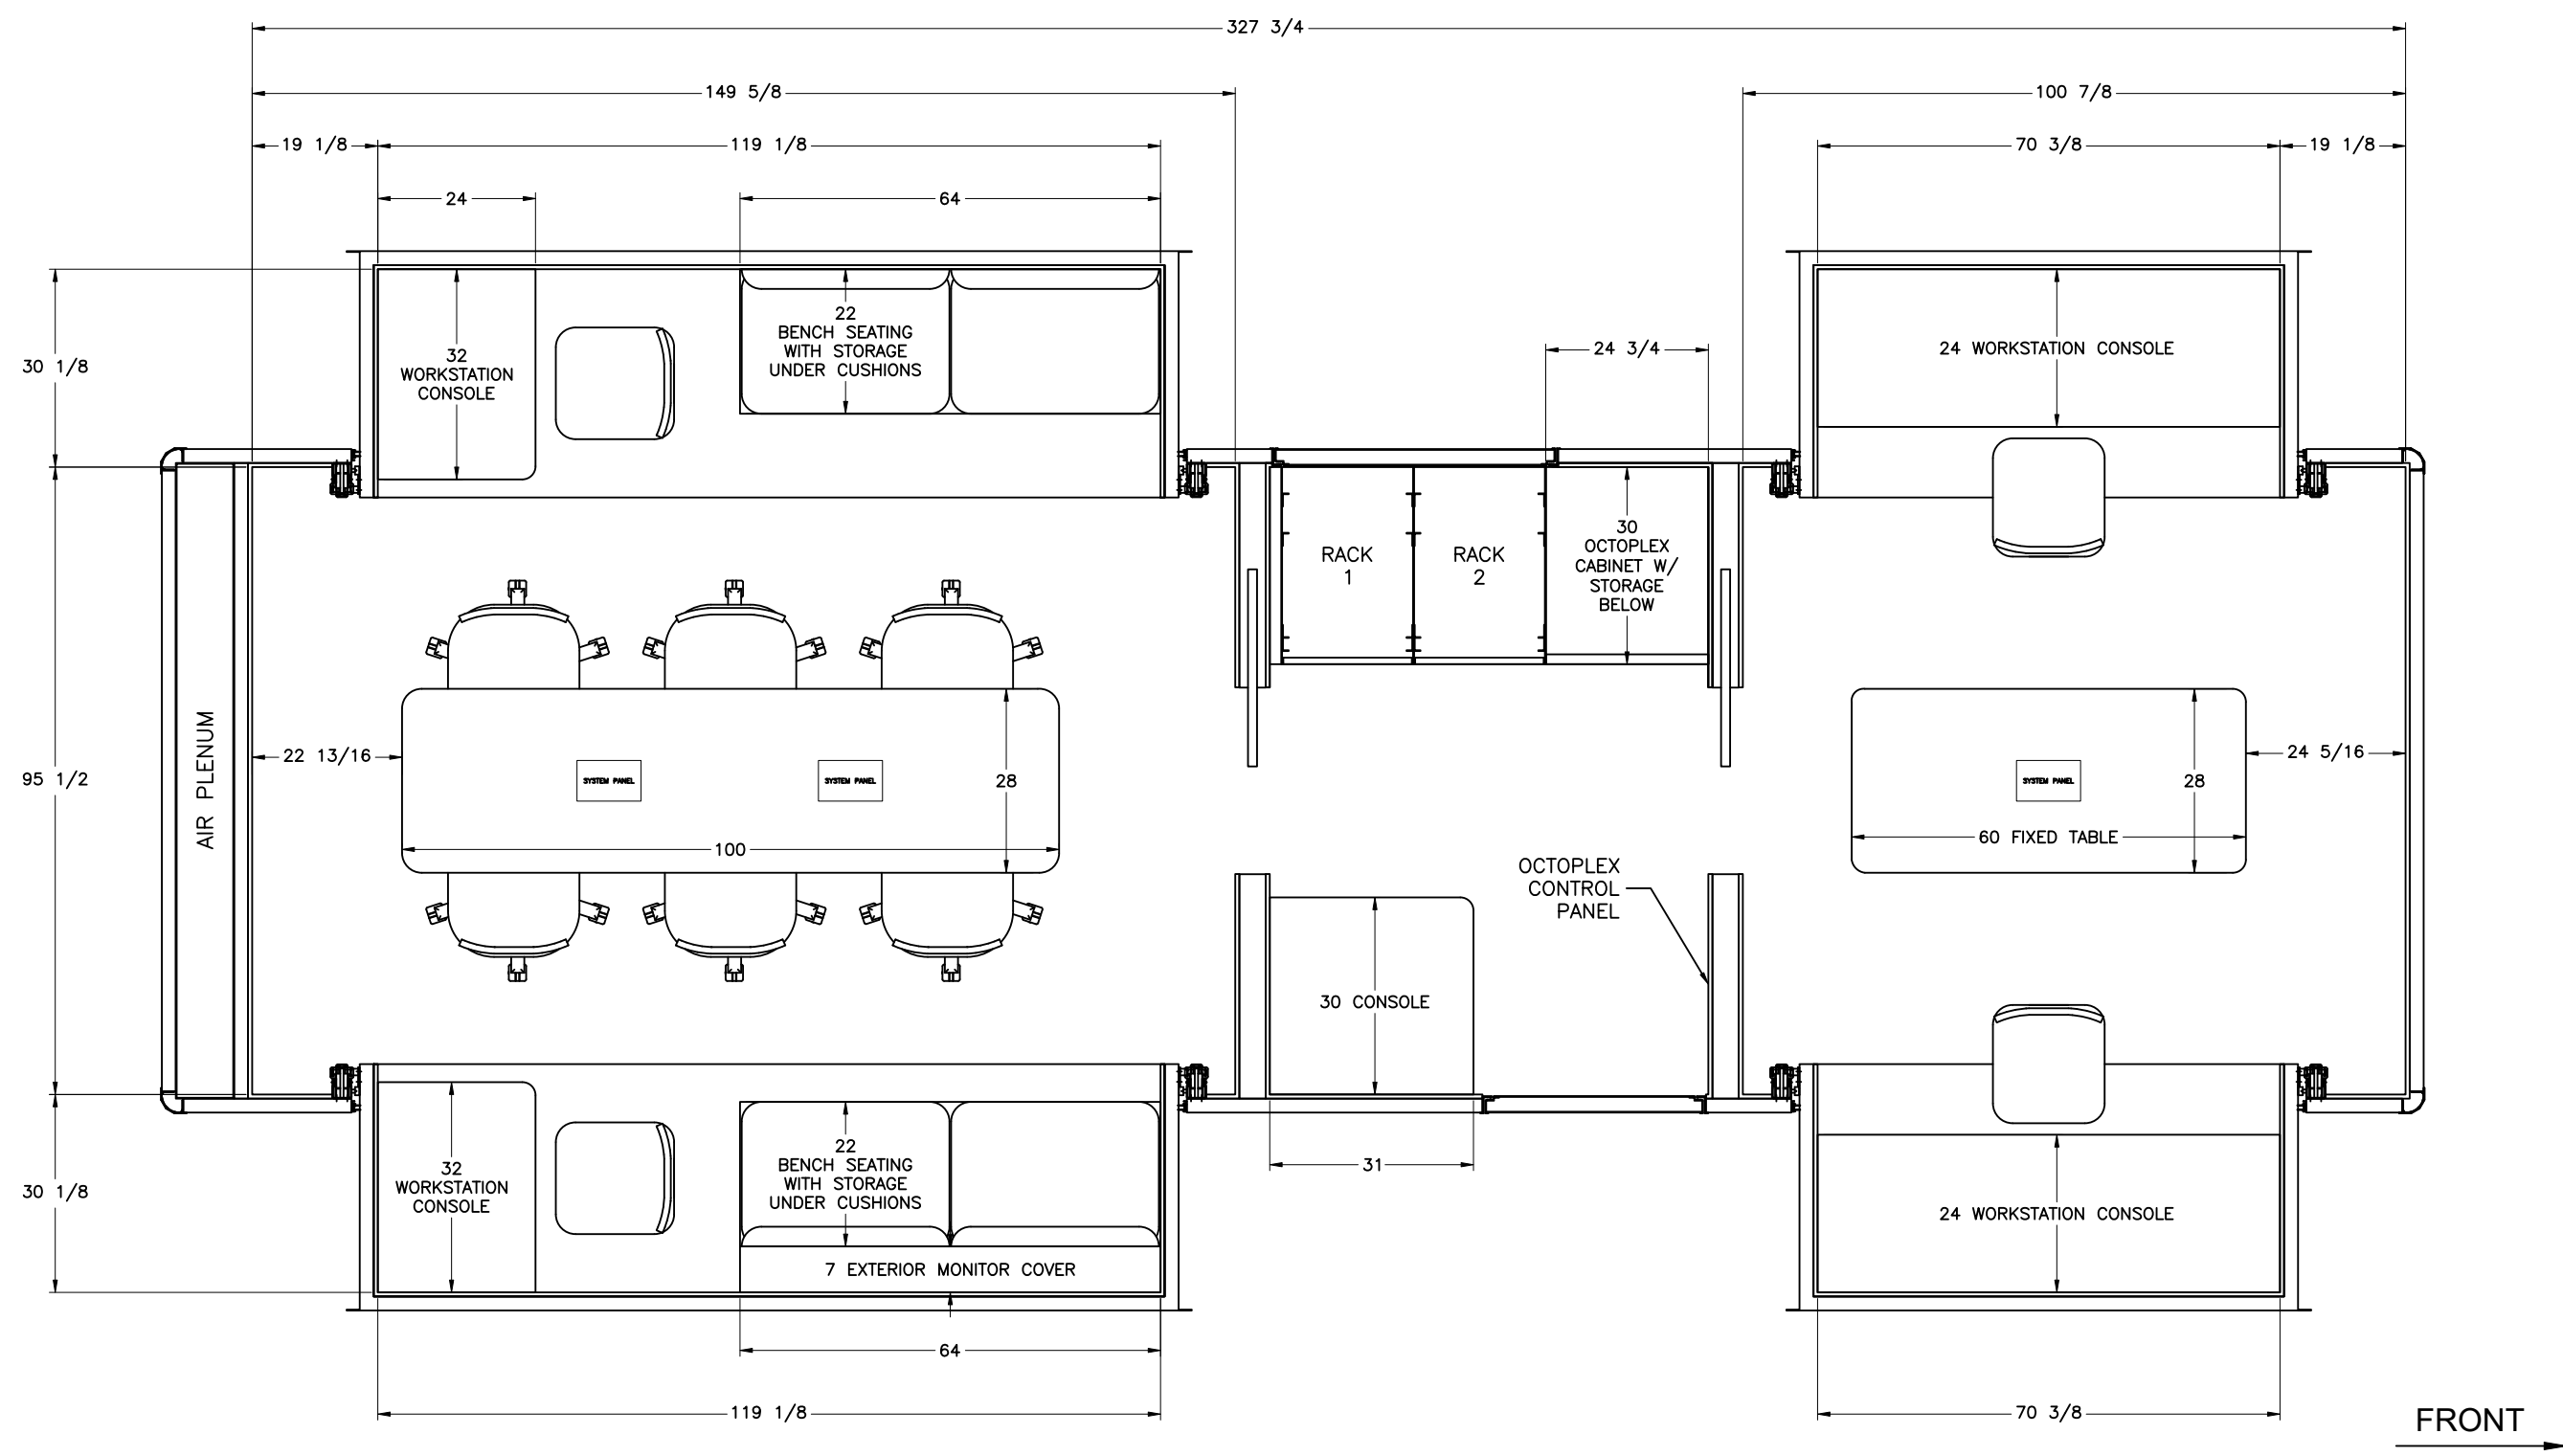

THIS DRAWING IS THE PROPERTY OF FRONTLINE COMMUNICATIONS CORPORATION. IT IS CONFIDENTIAL AND ALL RIGHTS ARE RESERVED. IT SHALL NOT BE REPRODUCED, COPIED, LENT, NOR USED FOR ANY PURPOSE OTHER THAN THAT FOR WHICH IT IS SPECIFICALLY FURNISHED.

DO NOT SCALE THIS DRAWING DIMENSIONS ARE IN INCHES UNLESS OTHERWISE SPECIFIED		MATERIAL <b>SEE NOTES</b>	
TOLERANCES: ANGULAR: ± 1° BEND: ± 1° 2 PLACE DECIMAL ± .010 3 PLACE DECIMAL ± .005 FRACTIONS ± 1/16		FINISH <b>MILL FINISH</b>	
JOB NUMBER OR PRODUCT LINE <b>91995</b>		DRAWN BY <b>VJP</b>	DATE <b>5/24/24</b>
SHEET <b>1 OF 1</b>	SCALE <b>30</b>	CHECKED BY <b>CJM</b>	DATE <b>6/26/24</b>


**FRONTLINE COMMUNICATIONS**  
An Oshkosh Corporation Company

12770 44th Street North  
Clearwater, FL 33762-4713  
(727) 573-0400  
FAX (727) 571-3295

**INTERIOR LAYOUT FLOOR**

SIZE **B** DWG NO. **91995-40100**

REVISIONS					
CHK DATE	CHK BY	DESCRIPTION	DATE	BY	REV
1/22/25	JAB	ADDED 43" MONITOR PER CO-4, AS-BUILT	1/22/25	CJM	03

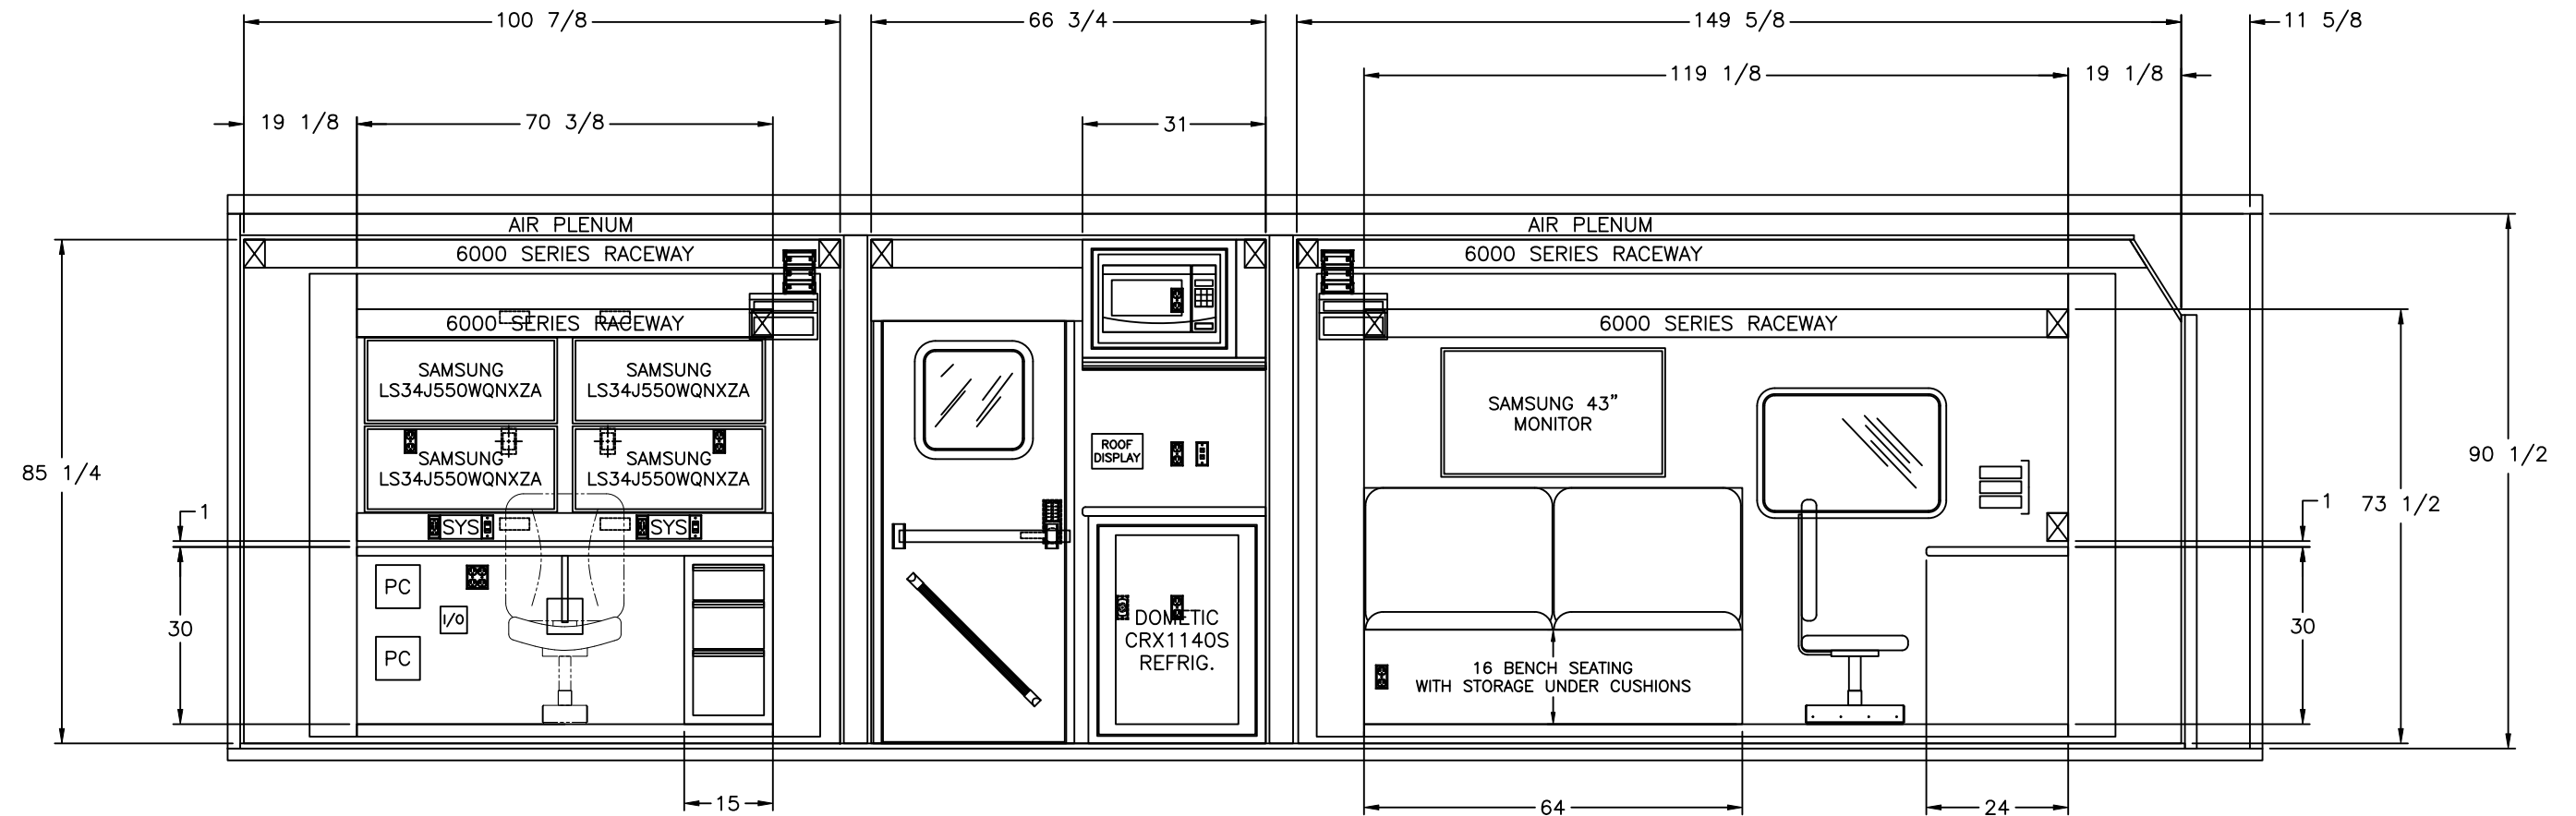


← FRONT

- NETWORK / PHONE
- DIMMER SWITCH (LED LIGHTS)
- 120V AC POWER / USB POWER
- 120V AC POWER (DUPLEX)
- 12V DC POWER
- LOW VOLTAGE DEVICE RING (SYSTEM)
- 120V AC POWER (QUAD)

THIS DRAWING IS THE PROPERTY OF FRONTLINE COMMUNICATIONS CORPORATION. IT IS CONFIDENTIAL AND ALL RIGHTS ARE RESERVED. IT SHALL NOT BE REPRODUCED, COPIED, LENT, NOR USED FOR ANY PURPOSE OTHER THAN THAT FOR WHICH IT IS SPECIFICALLY FURNISHED.

DO NOT SCALE THIS DRAWING DIMENSIONS ARE IN INCHES UNLESS OTHERWISE SPECIFIED		MATERIAL <b>SEE NOTES</b>		12770 44th Street North Clearwater, FL 33762-4713 (727) 573-0400 FAX (727) 571-3295 A Division of Pierce Manufacturing Inc.	
TOLERANCES: ANGULAR: ± 1° BEND: ± 1° 2 PLACE DECIMAL ± .010 3 PLACE DECIMAL ± .005 FRACTIONS ± 1/16		FINISH <b>MILL FINISH</b>		<b>INTERIOR LAYOUT CURB SIDE</b>	
JOB NUMBER OR PRODUCT LINE <b>91995</b>		DRAWN BY <b>VJP</b>	DATE <b>5/24/24</b>	SIZE <b>B</b>	DWG NO. <b>91995-40200</b>
SHEET <b>1 OF 1</b>	SCALE <b>30</b>	CHECKED BY <b>CJM</b>	DATE <b>6/26/24</b>		

REVISIONS						
CHK	DATE	CHK BY	DESCRIPTION	DATE	BY	REV
1/22/25		JAB	ADDED 43" MONITOR PER CO-4, AS-BUILT	1/22/25	CJM	03

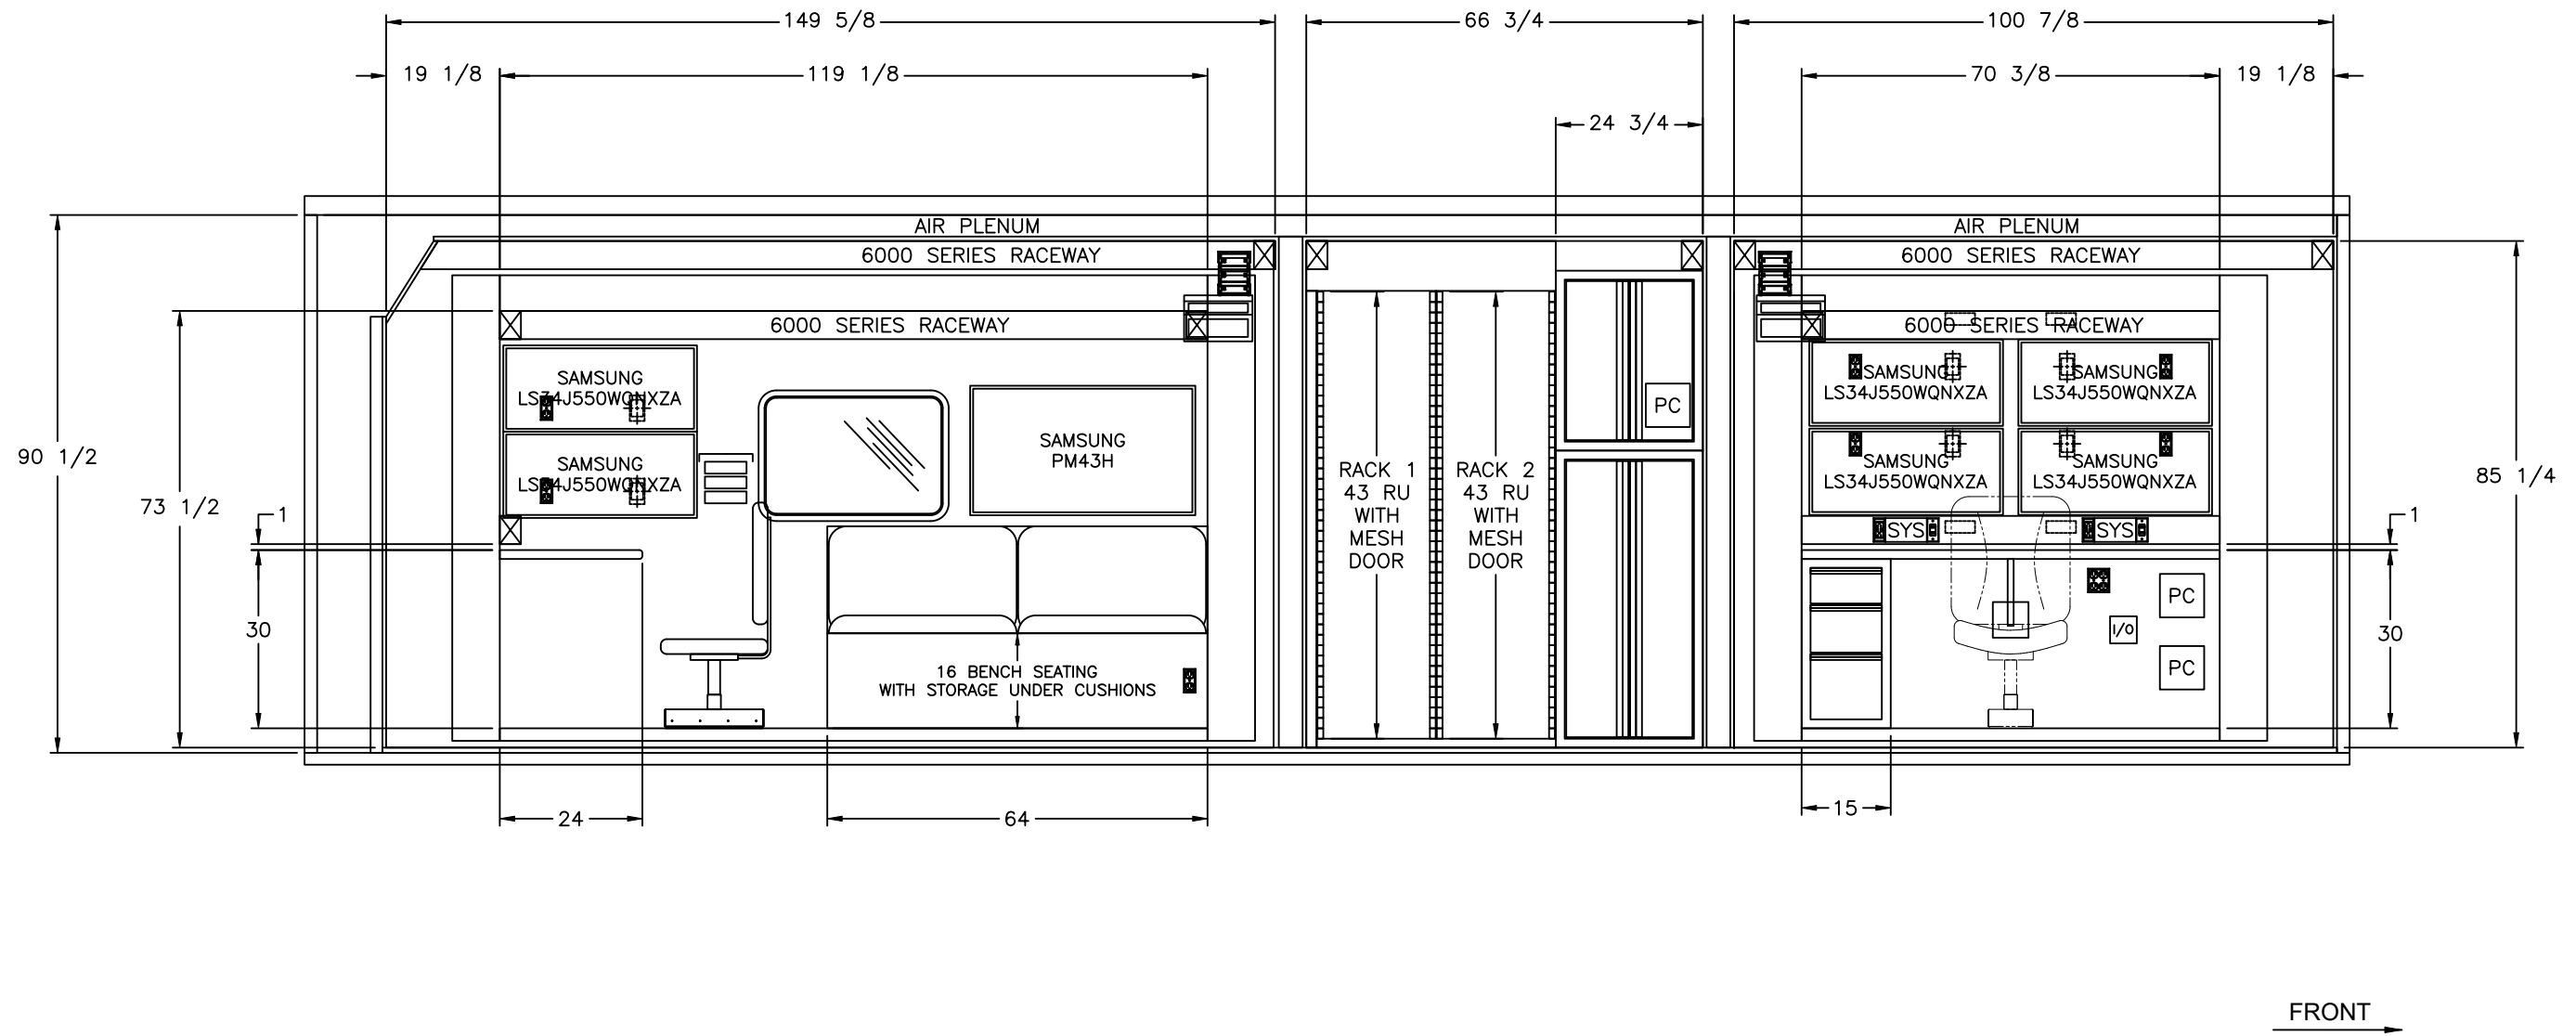






- DIMMER SWITCH (LED LIGHTS)
- 120V AC POWER / USB POWER
- 120V AC POWER (DUPLEX)
- 12V DC POWER
- LOW VOLTAGE DEVICE RING (SYSTEM)
- 120V AC POWER (QUAD)

THIS DRAWING IS THE PROPERTY OF FRONTLINE COMMUNICATIONS CORPORATION. IT IS CONFIDENTIAL AND ALL RIGHTS ARE RESERVED. IT SHALL NOT BE REPRODUCED, COPIED, LENT, NOR USED FOR ANY PURPOSE OTHER THAN THAT FOR WHICH IT IS SPECIFICALLY FURNISHED.

DO NOT SCALE THIS DRAWING DIMENSIONS ARE IN INCHES UNLESS OTHERWISE SPECIFIED		MATERIAL <b>SEE NOTES</b>		<b>FRONTLINE COMMUNICATIONS</b> <small>12770 44th Street North Clearwater, FL 33762-4713 (727) 573-0400 FAX (727) 571-3295</small> A Division of Pierce Manufacturing Inc.	
TOLERANCES: ANGULAR: ± 1° BEND: ± 1° 2 PLACE DECIMAL ± .010 3 PLACE DECIMAL ± .005 FRACTIONS ± 1/16		FINISH <b>MILL FINISH</b>		<b>INTERIOR LAYOUT STREET SIDE</b>	
JOB NUMBER OR PRODUCT LINE <b>91995</b>		DRAWN BY <b>VJP</b> DATE <b>5/24/24</b>			
SHEET <b>1 OF 1</b> SCALE <b>30</b>		CHECKED BY <b>CJM</b> DATE <b>6/26/24</b>		SIZE <b>B</b> DWG NO. <b>91995-40300</b>	

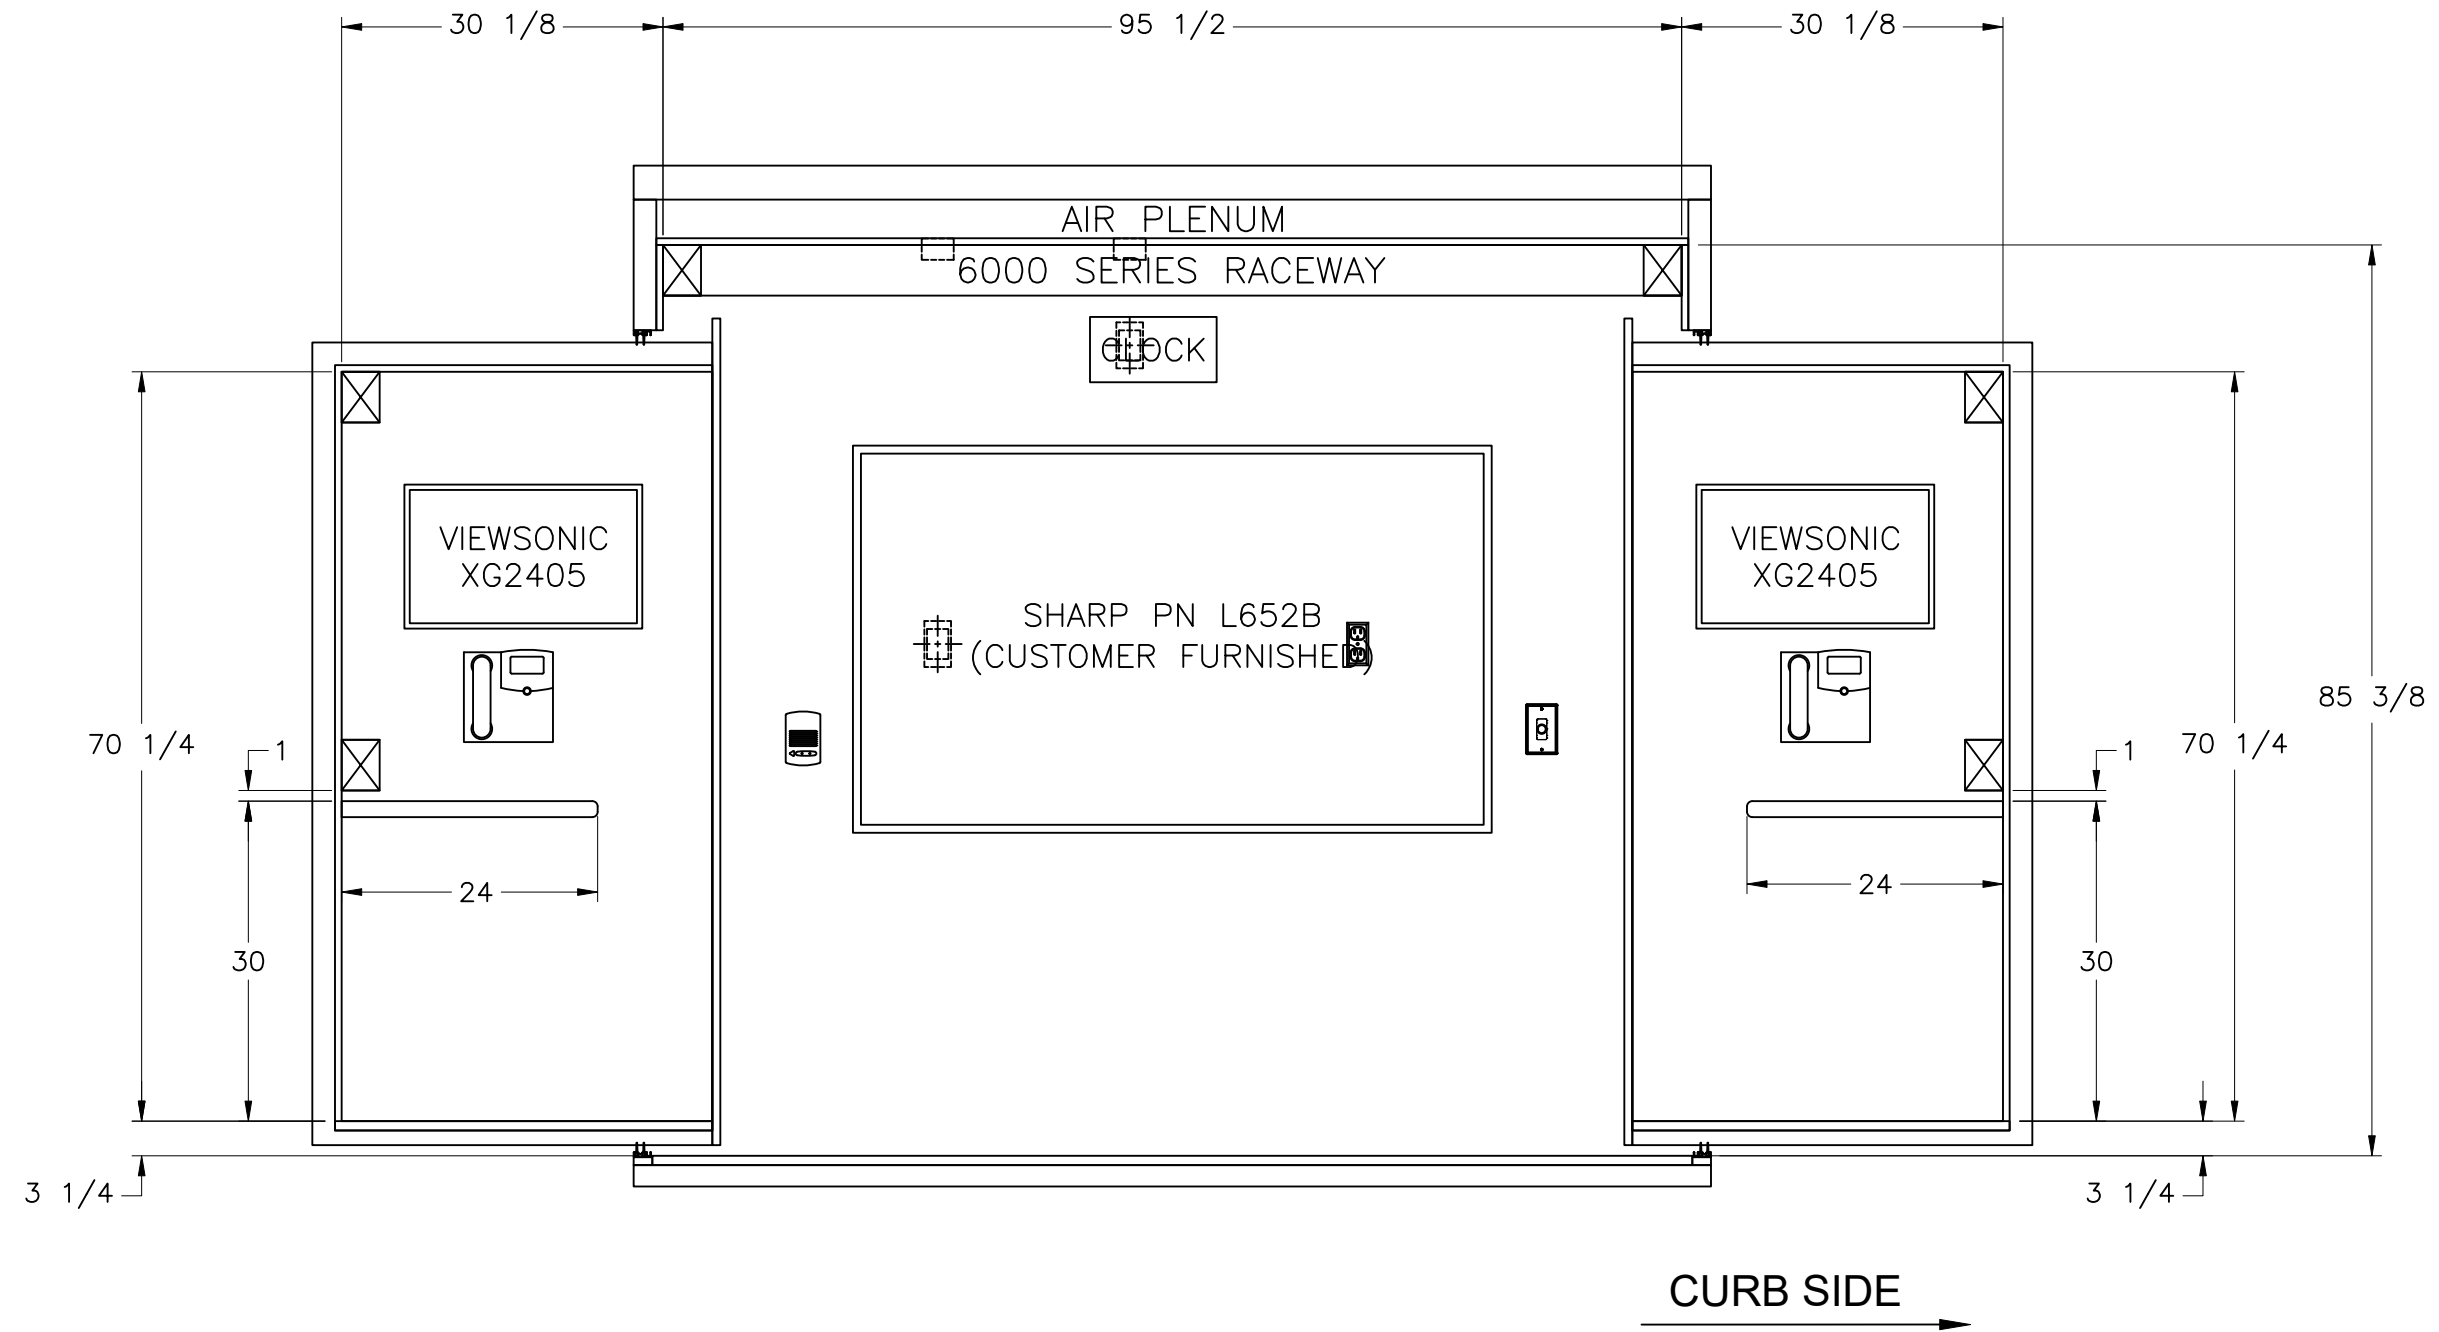REVISIONS					
CHK DATE	CHK BY	DESCRIPTION	DATE	BY	REV
1/22/25	JAB	ADDED 34" MONITORS PER CO-4, AS-BUILT	1/22/25	CJM	03

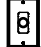


-  - VOLUME CONTROL
-  - 120V AC POWER (DUPLEX)
-  - LOW VOLTAGE DEVICE RING (SYSTEM)
-  - CO DETECTOR

THIS DRAWING IS THE PROPERTY OF FRONTLINE COMMUNICATIONS CORPORATION. IT IS CONFIDENTIAL AND ALL RIGHTS ARE RESERVED. IT SHALL NOT BE REPRODUCED, COPIED, LENT, NOR USED FOR ANY PURPOSE OTHER THAN THAT FOR WHICH IT IS SPECIFICALLY FURNISHED.

DO NOT SCALE THIS DRAWING DIMENSIONS ARE IN INCHES UNLESS OTHERWISE SPECIFIED		MATERIAL <b>SEE NOTES</b>		<b>FRONTLINE COMMUNICATIONS</b> <small>12770 44th Street North Clearwater, FL 33762-4713 (727) 573-0400 FAX (727) 571-3295</small> <b>INTERIOR LAYOUT FRONT WALL</b>	
TOLERANCES: ANGULAR: ± 1° BEND: ± 1" 2 PLACE DECIMAL ± .010 3 PLACE DECIMAL ± .005 FRACTIONS ± 1/16		FINISH <b>MILL FINISH</b>			
JOB NUMBER OR PRODUCT LINE <b>91995</b>		DRAWN BY <b>VJP</b>	DATE <b>5/24/24</b>	SIZE <b>B</b>	DWG NO. <b>91995-40400</b>
SHEET <b>1 OF 1</b>	SCALE <b>18</b>	CHECKED BY <b>CJM</b>	DATE <b>6/26/24</b>		

REVISIONS					
CHK DATE	CHK BY	DESCRIPTION	DATE	BY	REV
8/15/24	JAB	CHANGED 65" MONITOR, DOUBLE STACK ULTRAWIDE 34" BOTH SIDES	8/15/24	CJM	02

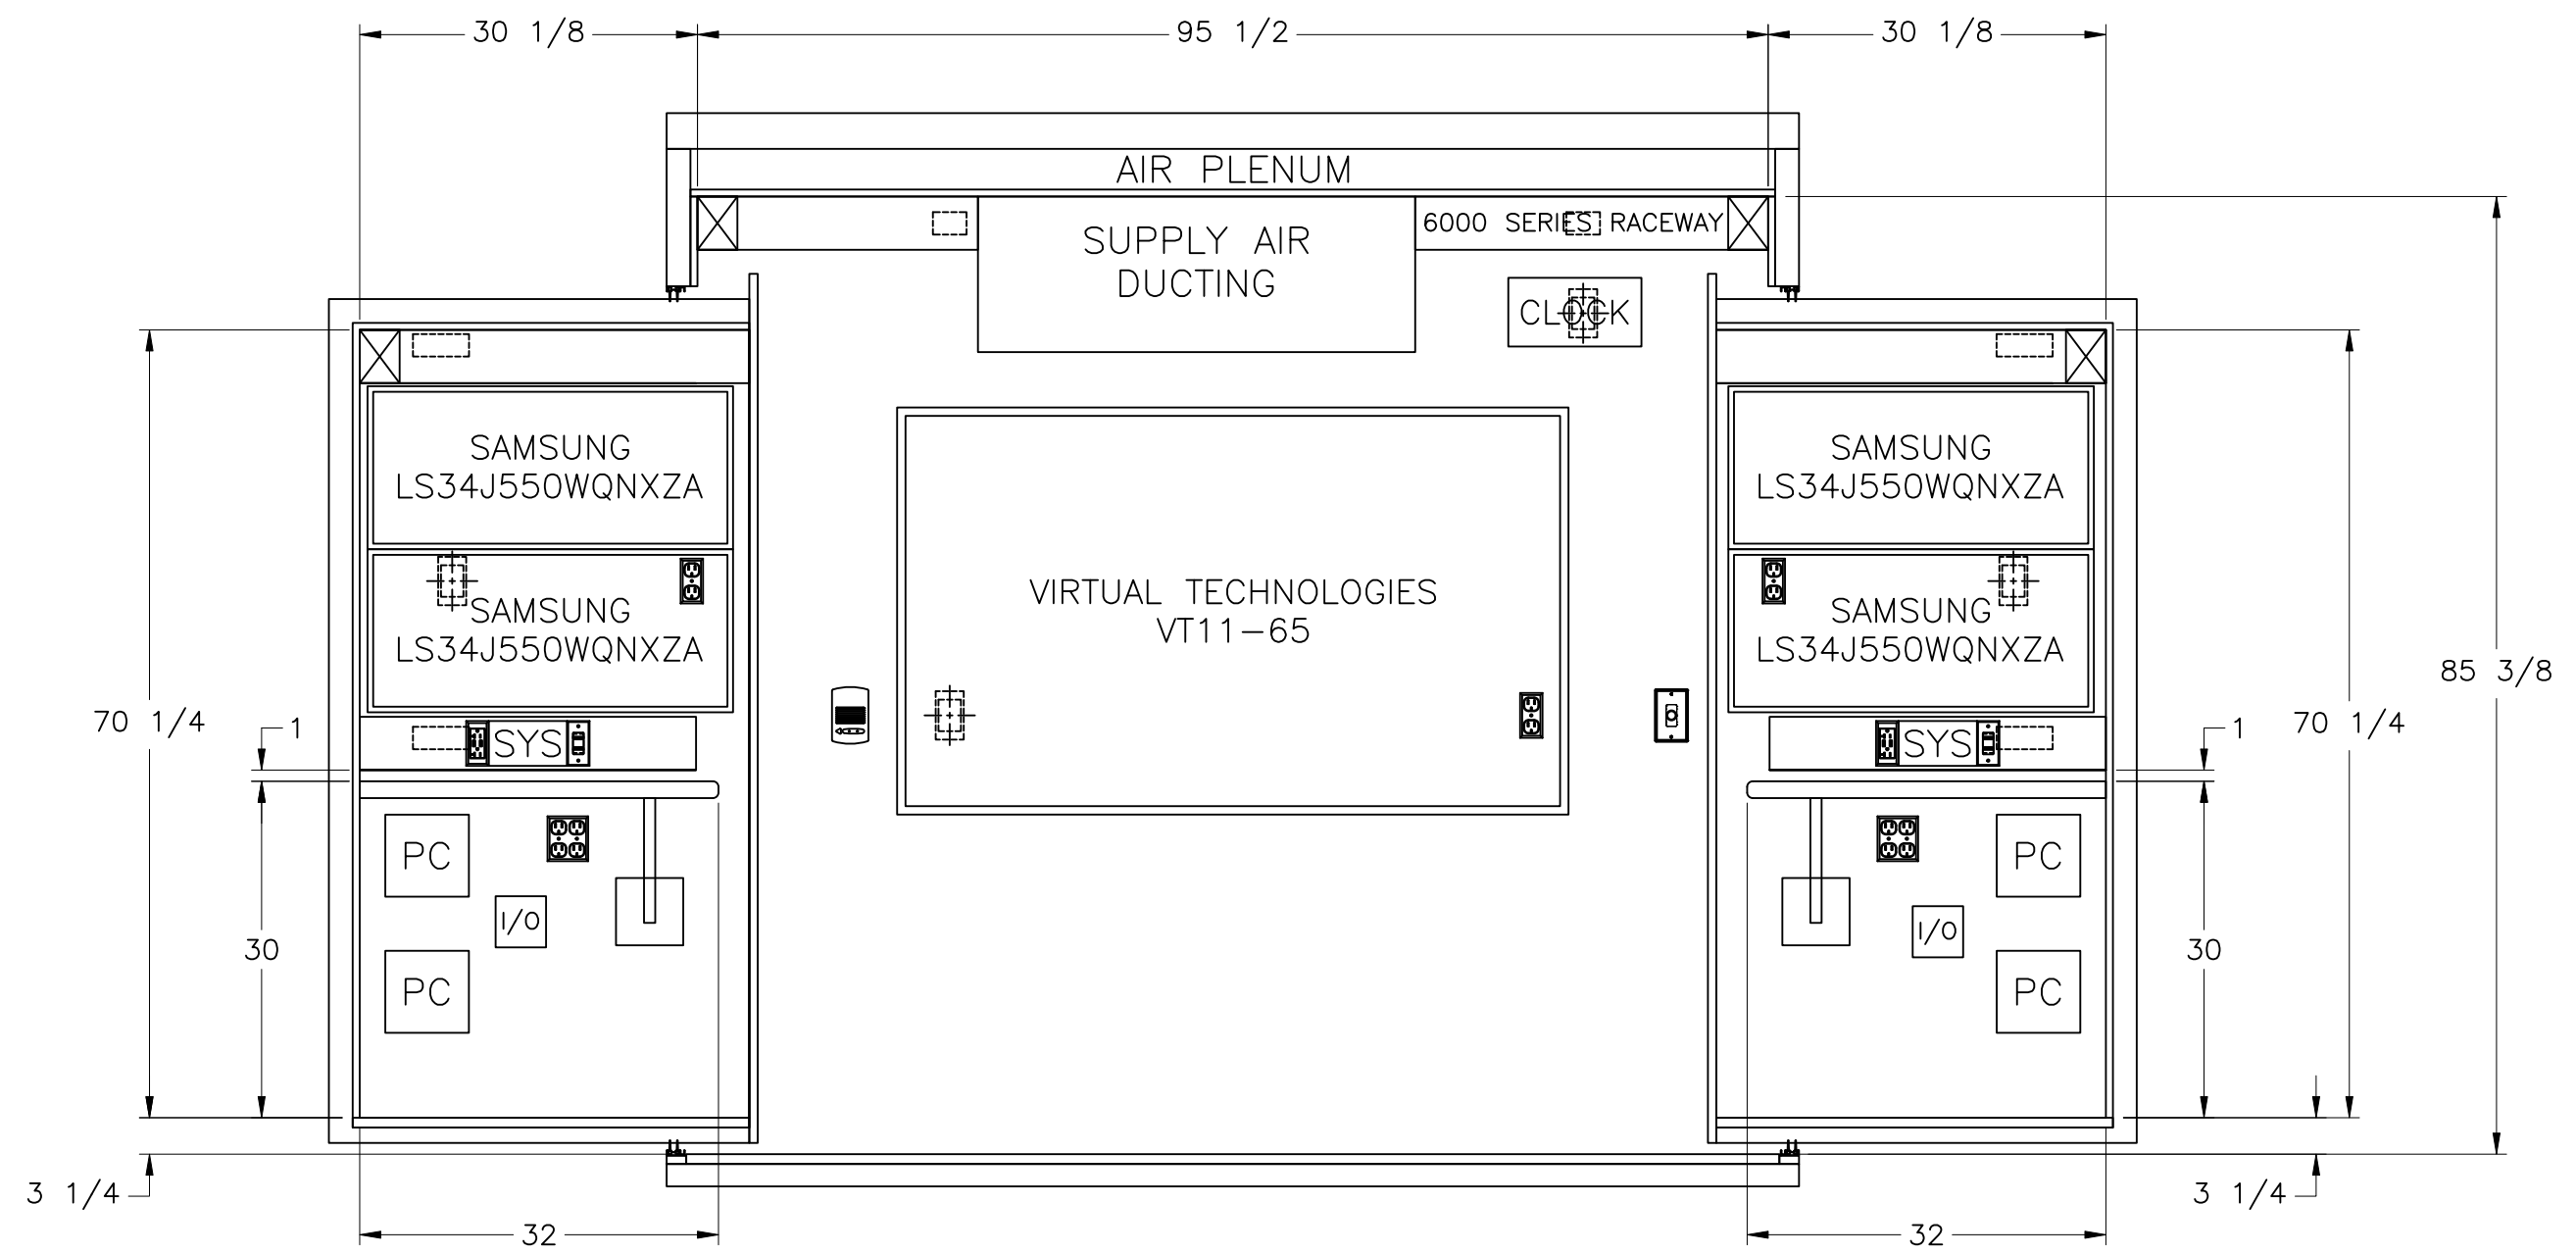


**CURB SIDE** ←

- VOLUME CONTROL
- 120V AC POWER (DUPLEX)
- LOW VOLTAGE DEVICE RING (SYSTEM)
- CO DETECTOR
- 120V AC POWER (QUAD)

THIS DRAWING IS THE PROPERTY OF FRONTLINE COMMUNICATIONS CORPORATION. IT IS CONFIDENTIAL AND ALL RIGHTS ARE RESERVED. IT SHALL NOT BE REPRODUCED, COPIED, LENT, NOR USED FOR ANY PURPOSE OTHER THAN THAT FOR WHICH IT IS SPECIFICALLY FURNISHED.

DO NOT SCALE THIS DRAWING DIMENSIONS ARE IN INCHES UNLESS OTHERWISE SPECIFIED		MATERIAL <b>SEE NOTES</b>		12770 44th Street North Clearwater, FL 33762-4713 (727) 573-0400 FAX (727) 571-3295	
TOLERANCES: ANGULAR: ± 1° BEND: ± 1° 2 PLACE DECIMAL ± .010 3 PLACE DECIMAL ± .005 FRACTIONS ± 1/16		FINISH <b>MILL FINISH</b>		<b>INTERIOR LAYOUT REAR WALL</b>	
JOB NUMBER OR PRODUCT LINE <b>91995</b>		DRAWN BY <b>VJP</b>	DATE <b>5/24/24</b>		
SHEET <b>1 OF 1</b>	SCALE <b>18</b>	CHECKED BY <b>CJM</b>	DATE <b>6/26/24</b>	SIZE <b>B</b>	DWG NO. <b>91995-40500</b>

REVISIONS					
CHK DATE	CHK BY	DESCRIPTION	DATE	BY	REV
8/8/24	JAB	REMOVED OH CABINETS, RELOCATED LIGHTS TO CEILING	8/8/24	CJM	02

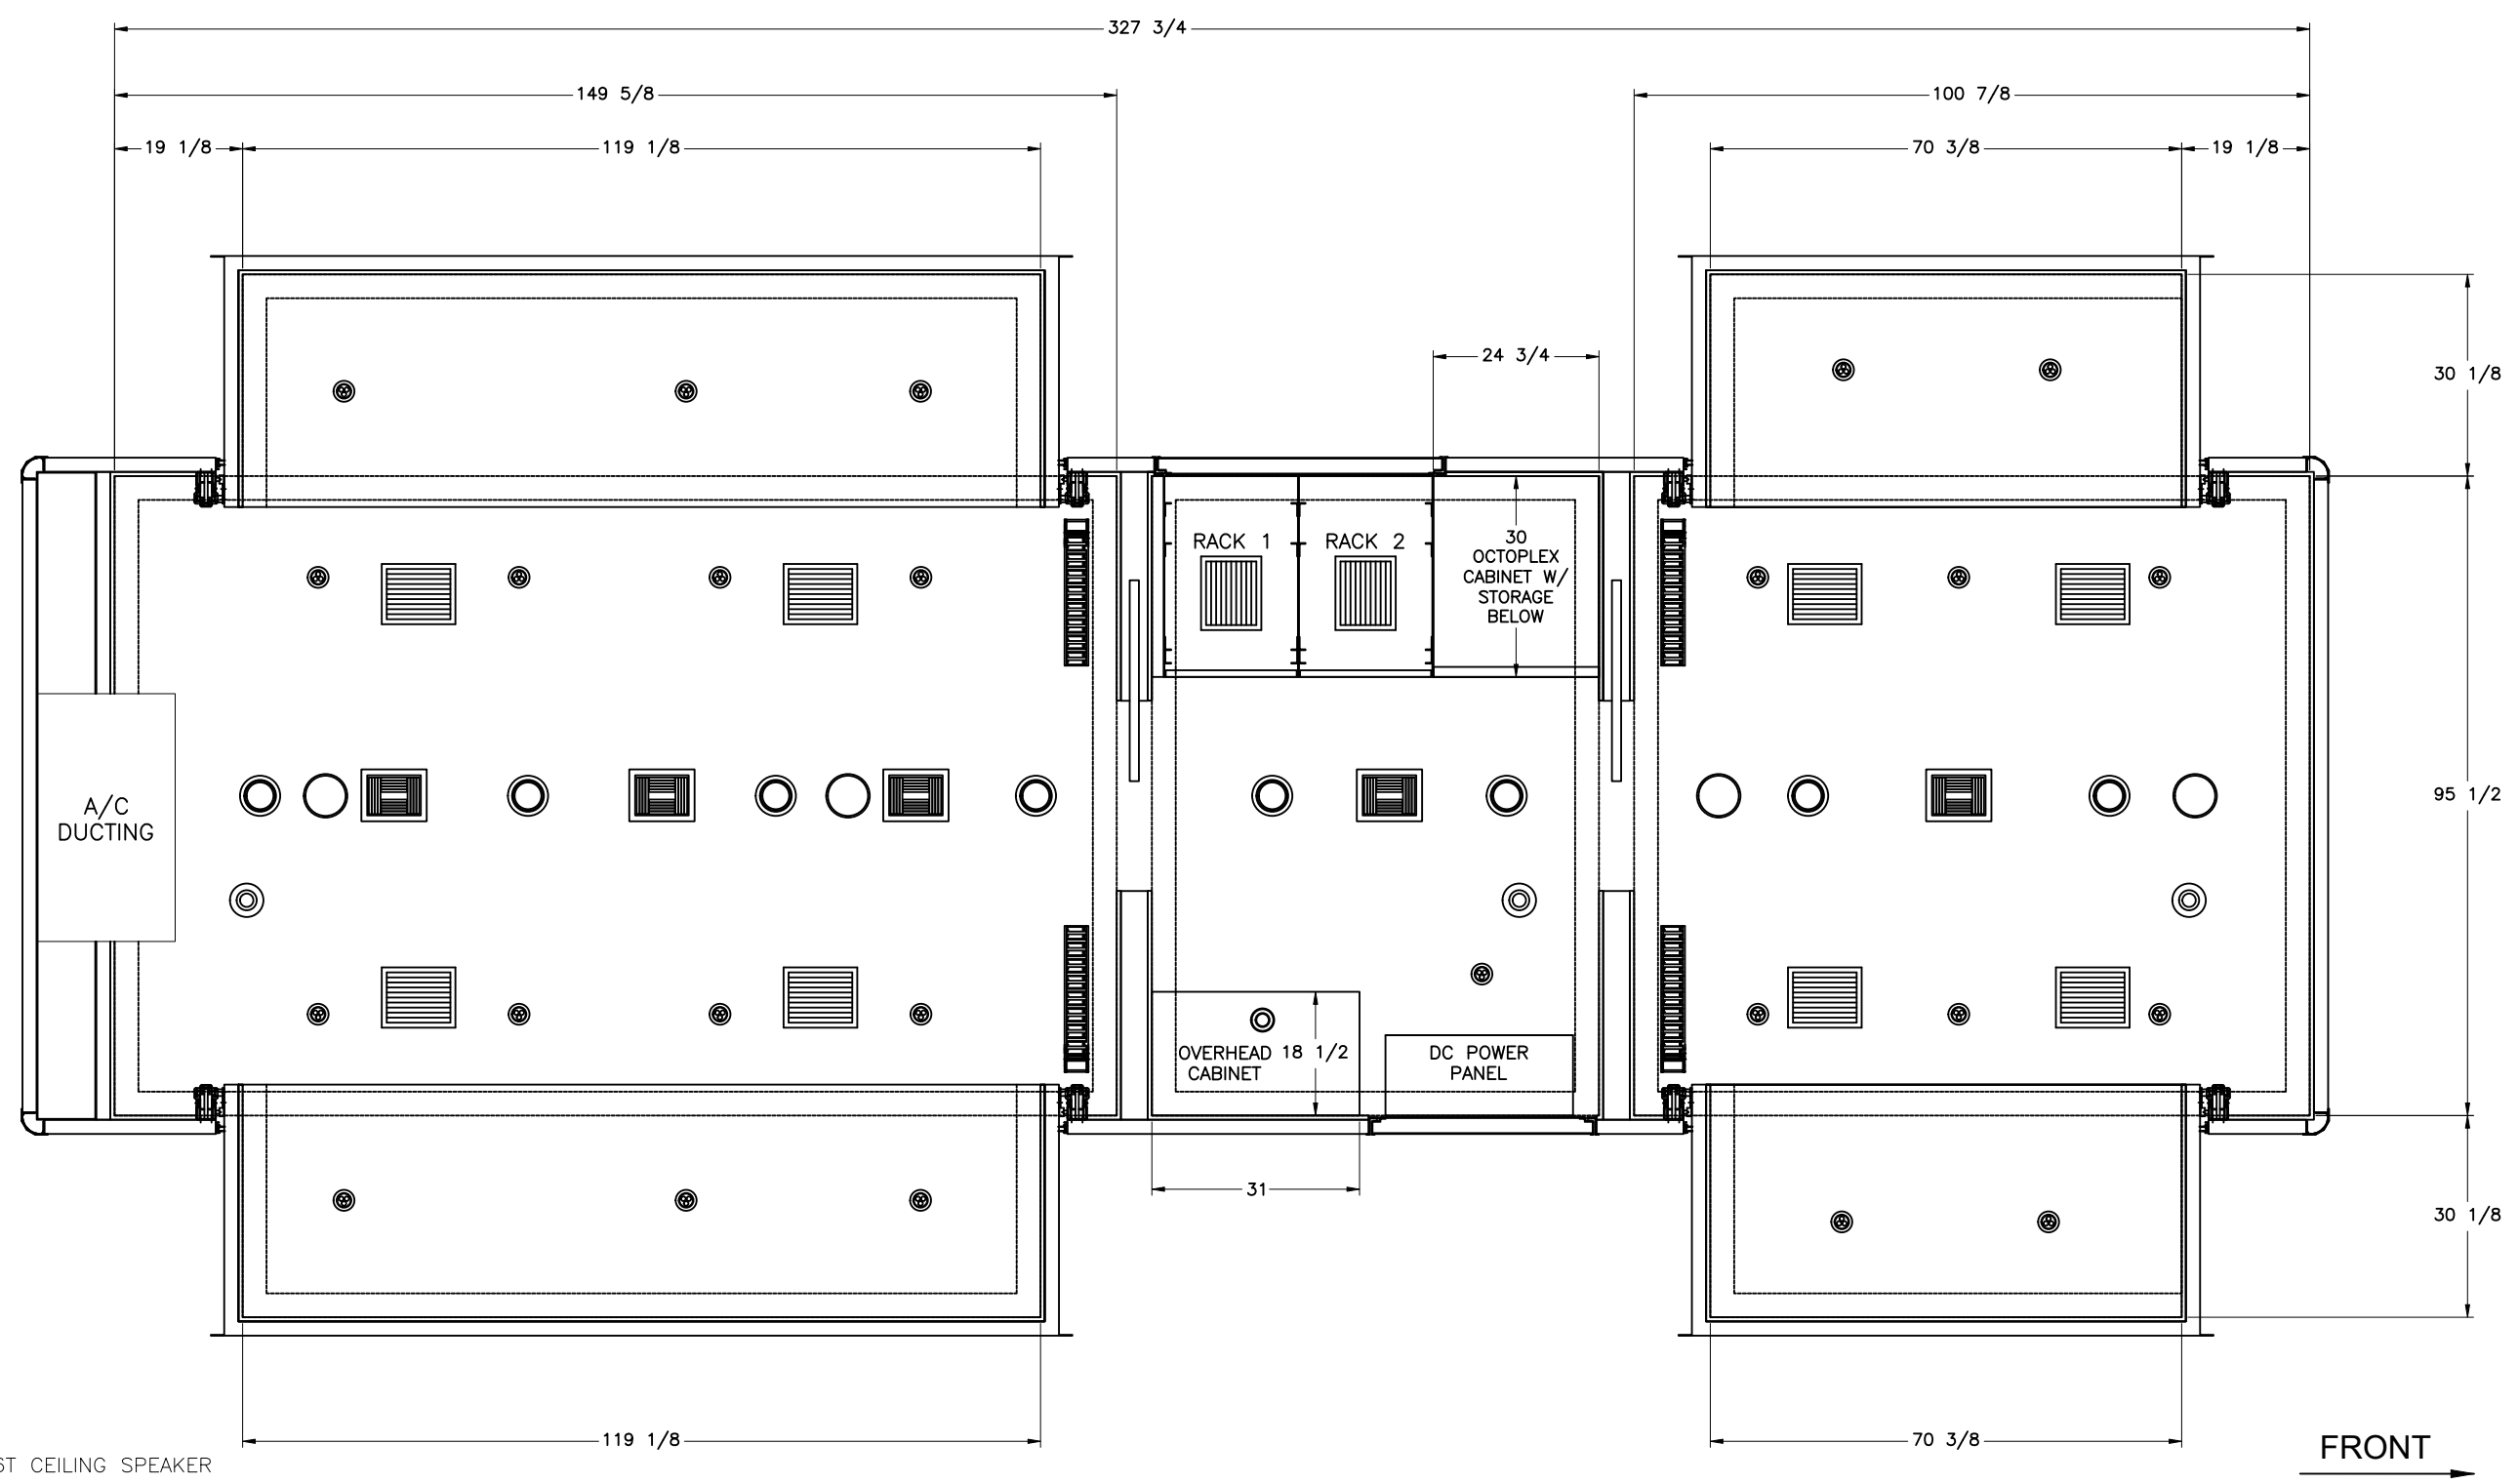


- ROCKVILLE CCL6T CEILING SPEAKER
- PROFILE UNDER CABINET LED LIGHT
- APEIRON LED LIGHT
- PRO XL APEIRON LED LIGHT
- SMOKE DETECTOR
- AIR SUPPLY VENT
- AIR RETURN VENT

THIS DRAWING IS THE PROPERTY OF FRONTLINE COMMUNICATIONS CORPORATION. IT IS CONFIDENTIAL AND ALL RIGHTS ARE RESERVED. IT SHALL NOT BE REPRODUCED, COPIED, LENT, NOR USED FOR ANY PURPOSE OTHER THAN THAT FOR WHICH IT IS SPECIFICALLY FURNISHED.




DO NOT SCALE THIS DRAWING DIMENSIONS ARE IN INCHES UNLESS OTHERWISE SPECIFIED		MATERIAL <b>SEE NOTES</b>		<b>FRONTLINE COMMUNICATIONS</b> <small>An Oshkosh Corporation Company</small> 12770 44th Street North Clearwater, FL 33762-4713 (727) 573-0400 FAX (727) 571-3295	
TOLERANCES: ANGULAR: ± 1° BEND: ± 1" 2 PLACE DECIMAL ± .010 3 PLACE DECIMAL ± .005 FRACTIONS ± 1/16		FINISH <b>MILL FINISH</b>		<b>INTERIOR LAYOUT CEILING</b>	
JOB NUMBER OR PRODUCT LINE <b>91995</b>		DRAWN BY <b>CJM</b>	DATE <b>7/13/23</b>		
SHEET <b>1 OF 1</b>	SCALE <b>30</b>	CHECKED BY <b>MRS</b>	DATE <b>7/19/23</b>	SIZE <b>B</b>	DWG NO. <b>91995-40600</b>

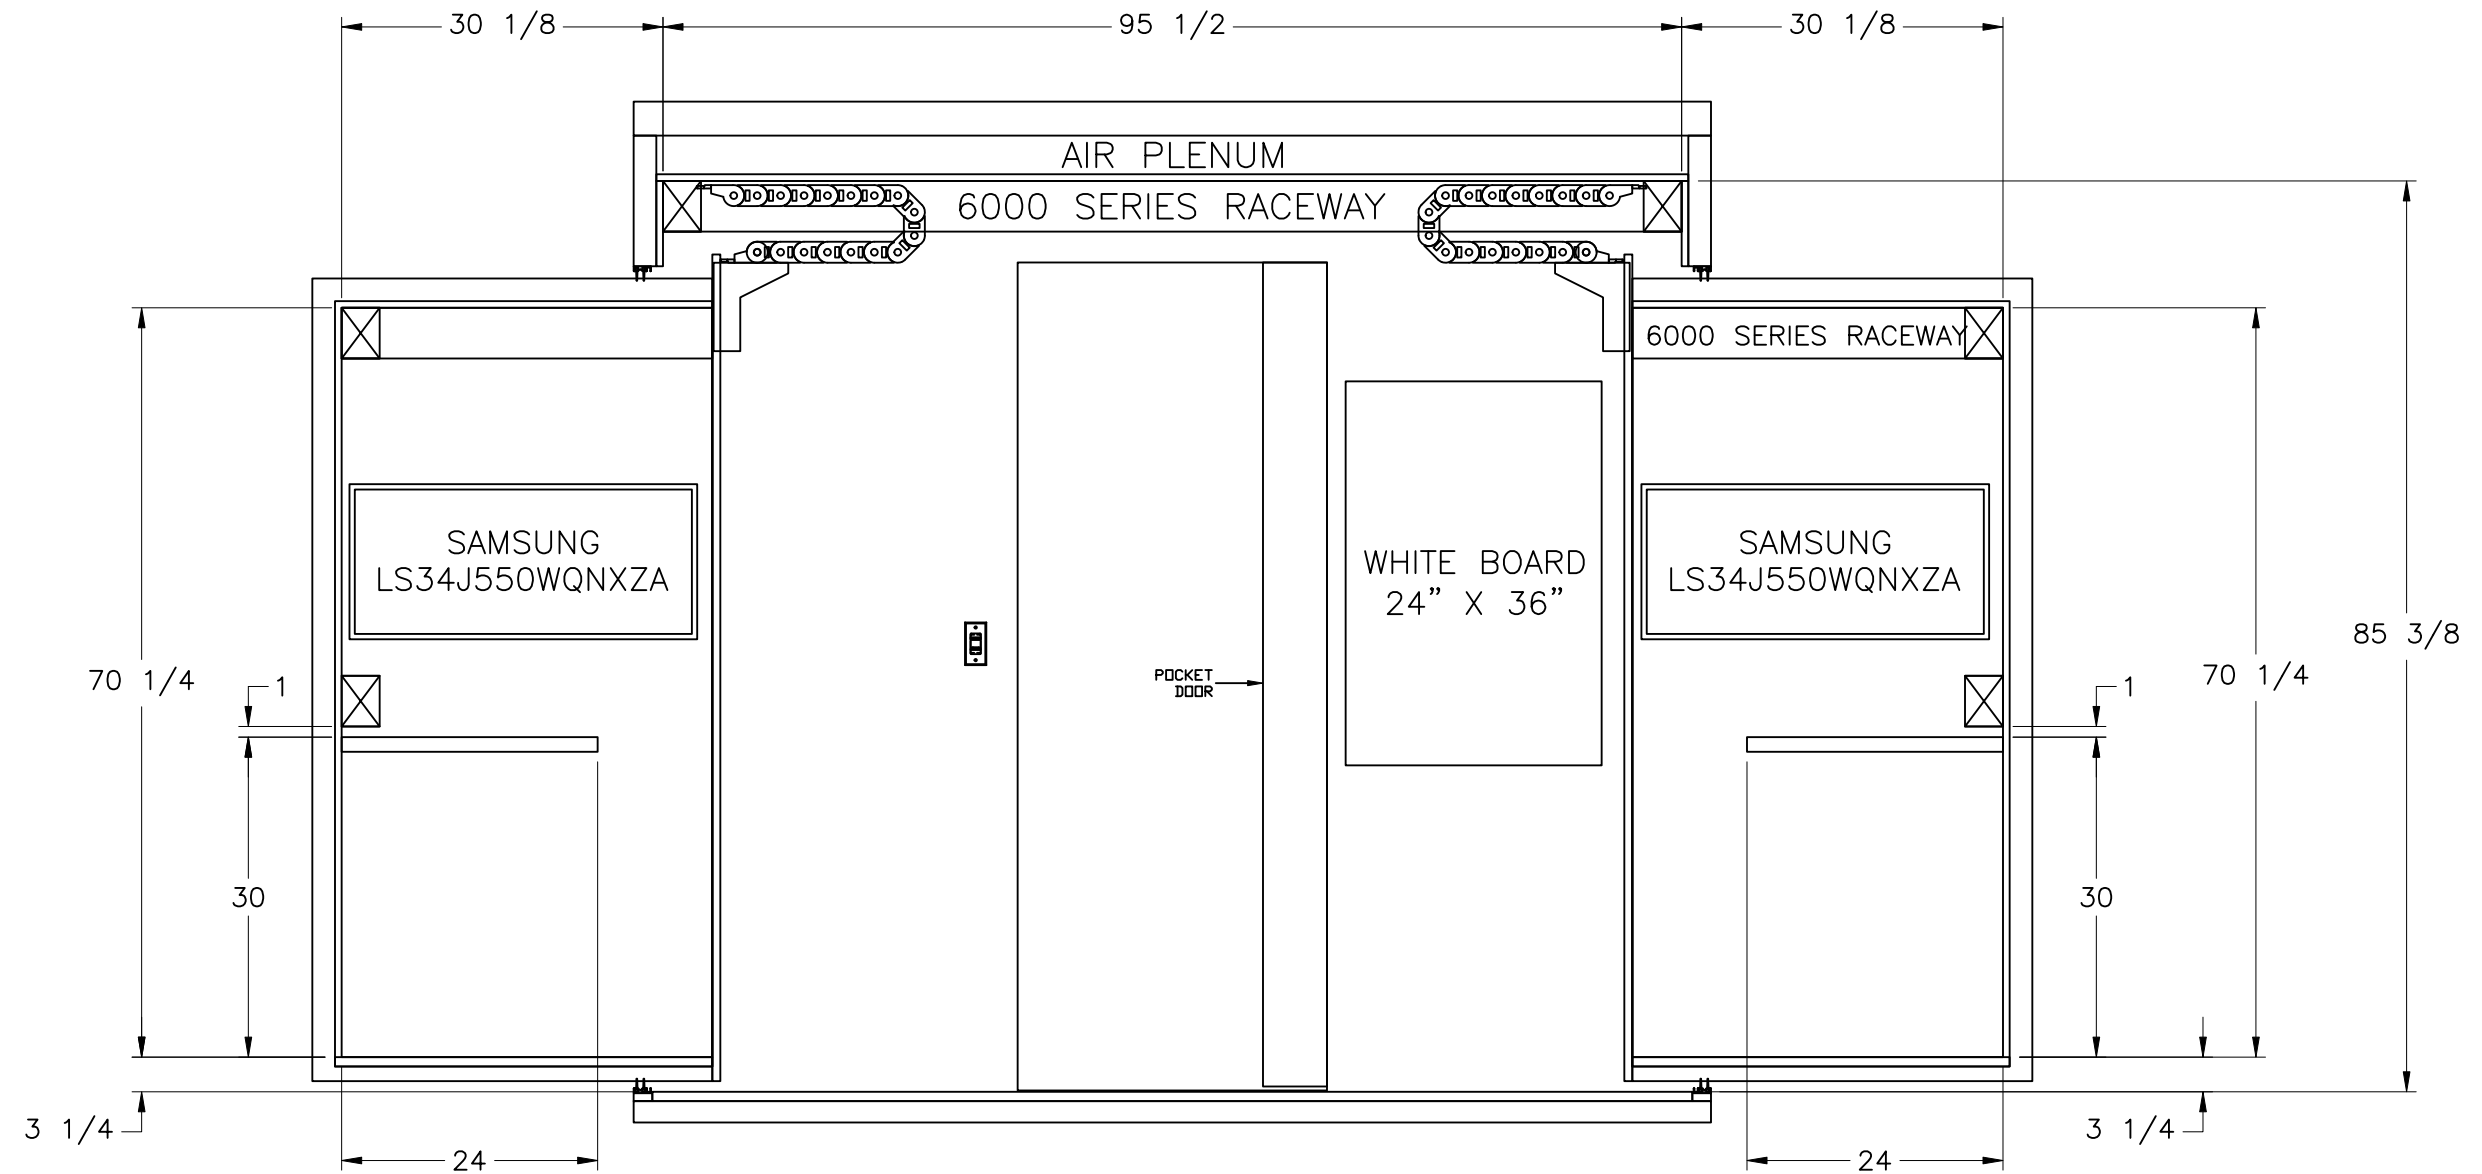REVISIONS						
CHK	DATE	CHK BY	DESCRIPTION	DATE	BY	REV
1/22/25		JAB	ADDED 34" MONITORS PER CO-4, AS-BUILT (SHEET 1)	1/22/25	CJM	03




PARTITION WALL – FRONT  
 FRONT PARTITION WALL  
 VIEWED FROM FRONT OF VEHICLE  
 FACING THE REAR OF THE VEHICLE


← CURB SIDE

-  – DIMMER SWITCH (LED LIGHTS)
-  – 120V AC POWER (DUPLEX)
-  – LOW VOLTAGE DEVICE RING (SYSTEM)

THIS DRAWING IS THE PROPERTY OF FRONTLINE COMMUNICATIONS CORPORATION. IT IS CONFIDENTIAL AND ALL RIGHTS ARE RESERVED. IT SHALL NOT BE REPRODUCED, COPIED, LENT, NOR USED FOR ANY PURPOSE OTHER THAN THAT FOR WHICH IT IS SPECIFICALLY FURNISHED.



DO NOT SCALE THIS DRAWING DIMENSIONS ARE IN INCHES UNLESS OTHERWISE SPECIFIED		MATERIAL <b>SEE NOTES</b>		 12770 44th Street North Clearwater, FL 33762-4713 (727) 573-0400 An Oshkosh Corporation Company FAX (727) 571-3295	
TOLERANCES: ANGULAR: ± 1° BEND: ± 1° 2 PLACE DECIMAL ± .010 3 PLACE DECIMAL ± .005 FRACTIONS ± 1/16		FINISH <b>MILL FINISH</b>		<b>INTERIOR LAYOUT PARTITION - FRONT</b>	
JOB NUMBER OR PRODUCT LINE <b>91995</b>		DRAWN BY <b>VJP</b>	DATE <b>5/24/24</b>	SIZE <b>B</b>	DWG NO. <b>91995-40700</b>
SHEET <b>1 OF 2</b>	SCALE <b>18</b>	CHECKED BY <b>CJM</b>	DATE <b>6/26/24</b>		

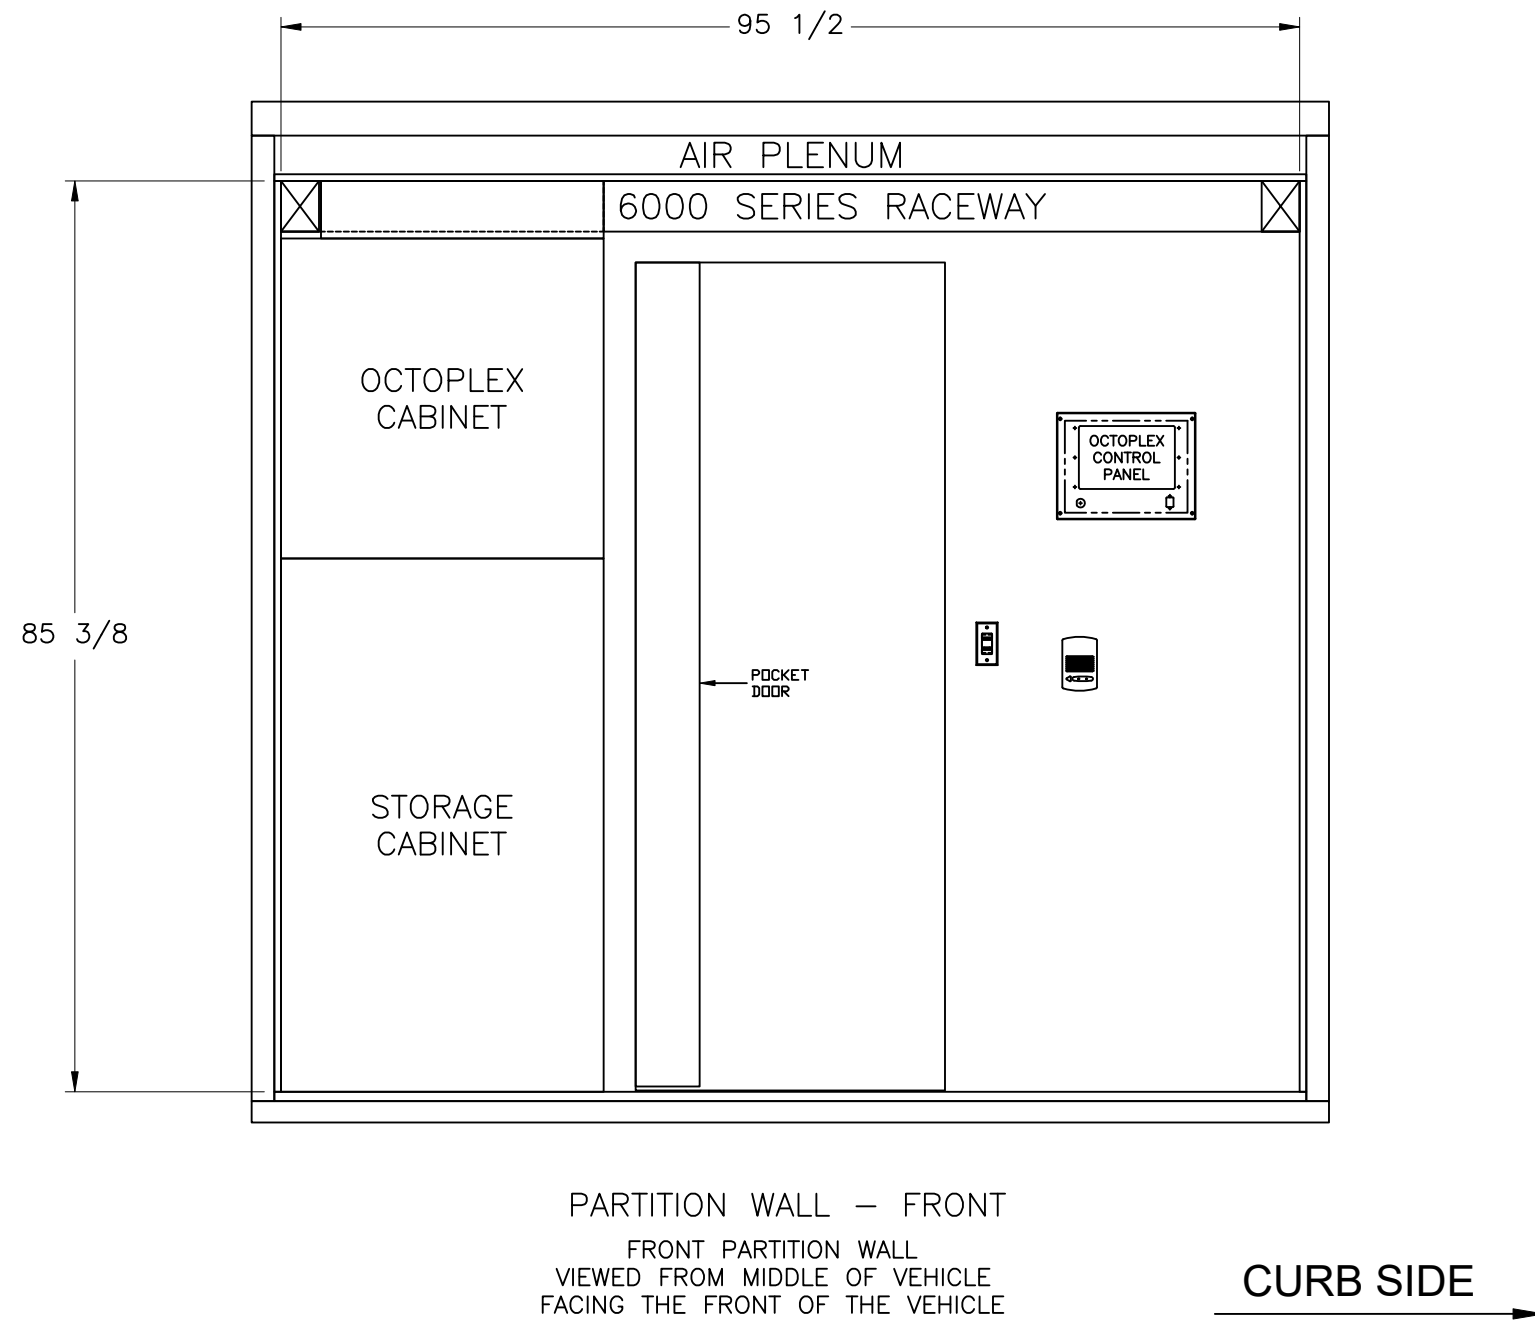REVISIONS					
CHK DATE	CHK BY	DESCRIPTION	DATE	BY	REV
1/22/25	JAB	ADDED 34" MONITORS PER CO-4, AS-BUILT (SHEET 1)	1/22/25	CJM	03



PARTITION WALL – FRONT  
 FRONT PARTITION WALL  
 VIEWED FROM MIDDLE OF VEHICLE  
 FACING THE FRONT OF THE VEHICLE

CURB SIDE →


-  – DIMMER SWITCH (LED LIGHTS)
-  – CO DETECTOR

THIS DRAWING IS THE PROPERTY OF FRONTLINE COMMUNICATIONS CORPORATION. IT IS CONFIDENTIAL AND ALL RIGHTS ARE RESERVED. IT SHALL NOT BE REPRODUCED, COPIED, LENT, NOR USED FOR ANY PURPOSE OTHER THAN THAT FOR WHICH IT IS SPECIFICALLY FURNISHED.

DO NOT SCALE THIS DRAWING DIMENSIONS ARE IN INCHES UNLESS OTHERWISE SPECIFIED		MATERIAL <b>SEE NOTES</b>		<b>FRONTLINE COMMUNICATIONS</b> <small>12770 44th Street North          Clearwater, FL 33762-4713          (727) 573-0400          An Oshkosh Corporation Company FAX (727) 571-3295</small>	
TOLERANCES: ANGULAR: ± 1° BEND: ± 1' 2 PLACE DECIMAL ± .010 3 PLACE DECIMAL ± .005 FRACTIONS ± 1/16		FINISH <b>MILL FINISH</b>		<b>INTERIOR LAYOUT          PARTITION - FRONT</b>	
JOB NUMBER OR PRODUCT LINE <b>91995</b>		DRAWN BY <b>VJP</b> DATE <b>5/24/24</b>			
SHEET <b>2 OF 2</b> SCALE <b>18</b>		CHECKED BY <b>CJM</b> DATE <b>6/26/24</b>		SIZE <b>B</b>	DWG NO. <b>91995-40700</b>





REVISIONS						
CHK	DATE	CHK BY	DESCRIPTION	DATE	BY	REV
1/22/25		JAB	ADDED WHITEBOARD PER CO-4, AS-BUILT (SHEET 1)	1/22/25	CJM	02

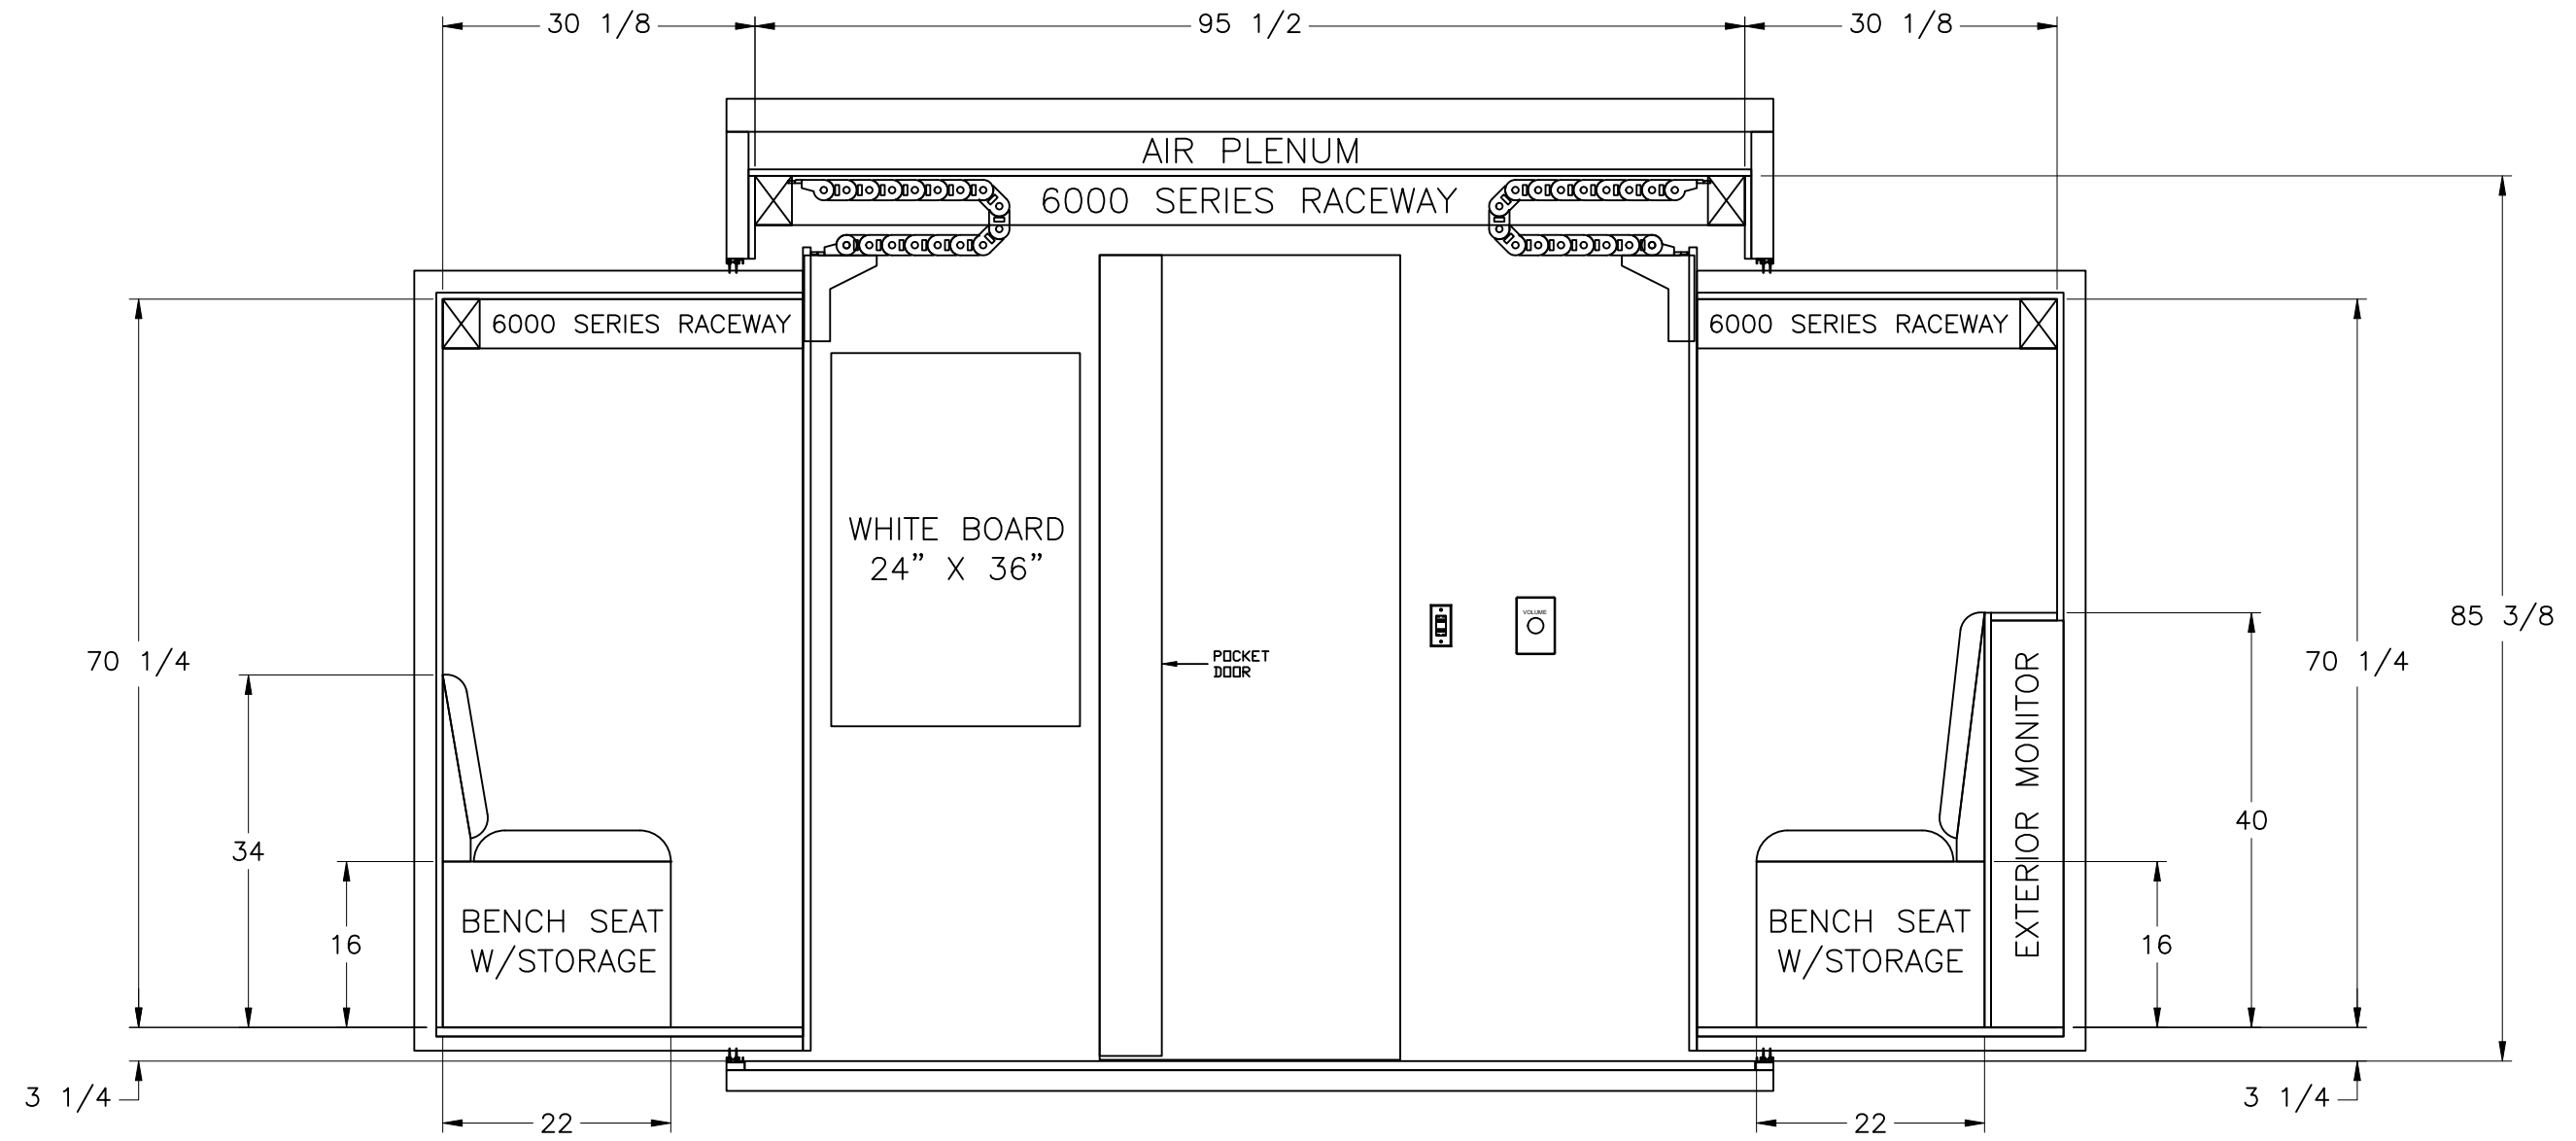

PARTITION WALL – REAR  
 REAR PARTITION WALL  
 VIEWED FROM REAR OF VEHICLE  
 FACING THE FRONT OF THE VEHICLE


CURB SIDE  
 →

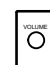-  – SPEAKER CONTROL VOLUME
-  – DIMMER SWITCH (LED LIGHTS)

THIS DRAWING IS THE PROPERTY OF FRONTLINE COMMUNICATIONS CORPORATION. IT IS CONFIDENTIAL AND ALL RIGHTS ARE RESERVED. IT SHALL NOT BE REPRODUCED, COPIED, LENT, NOR USED FOR ANY PURPOSE OTHER THAN THAT FOR WHICH IT IS SPECIFICALLY FURNISHED.

DO NOT SCALE THIS DRAWING DIMENSIONS ARE IN INCHES UNLESS OTHERWISE SPECIFIED		MATERIAL <b>SEE NOTES</b>		<b>FRONTLINE COMMUNICATIONS</b> <small>12770 44th Street North          Clearwater, FL 33762-4713          (727) 573-0400          An Oshkosh Corporation Company FAX (727) 571-3295</small>	
TOLERANCES: ANGULAR: ± 1° BEND: ± 1" 2 PLACE DECIMAL ± .010 3 PLACE DECIMAL ± .005 FRACTIONS ± 1/16		FINISH <b>MILL FINISH</b>		<b>INTERIOR LAYOUT PARTITION - REAR</b>	
JOB NUMBER OR PRODUCT LINE <b>91995</b>		DRAWN BY <b>VJP</b>	DATE <b>5/24/24</b>	SIZE <b>B</b>	DWG NO. <b>91995-40710</b>
SHEET <b>1 OF 2</b>	SCALE <b>18</b>	CHECKED BY <b>CJM</b>	DATE <b>6/26/24</b>		

REVISIONS					
CHK DATE	CHK BY	DESCRIPTION	DATE	BY	REV
1/22/25	JAB	ADDED WHITEBOARD PER CO-4, AS-BUILT (SHEET 1)	1/22/25	CJM	02

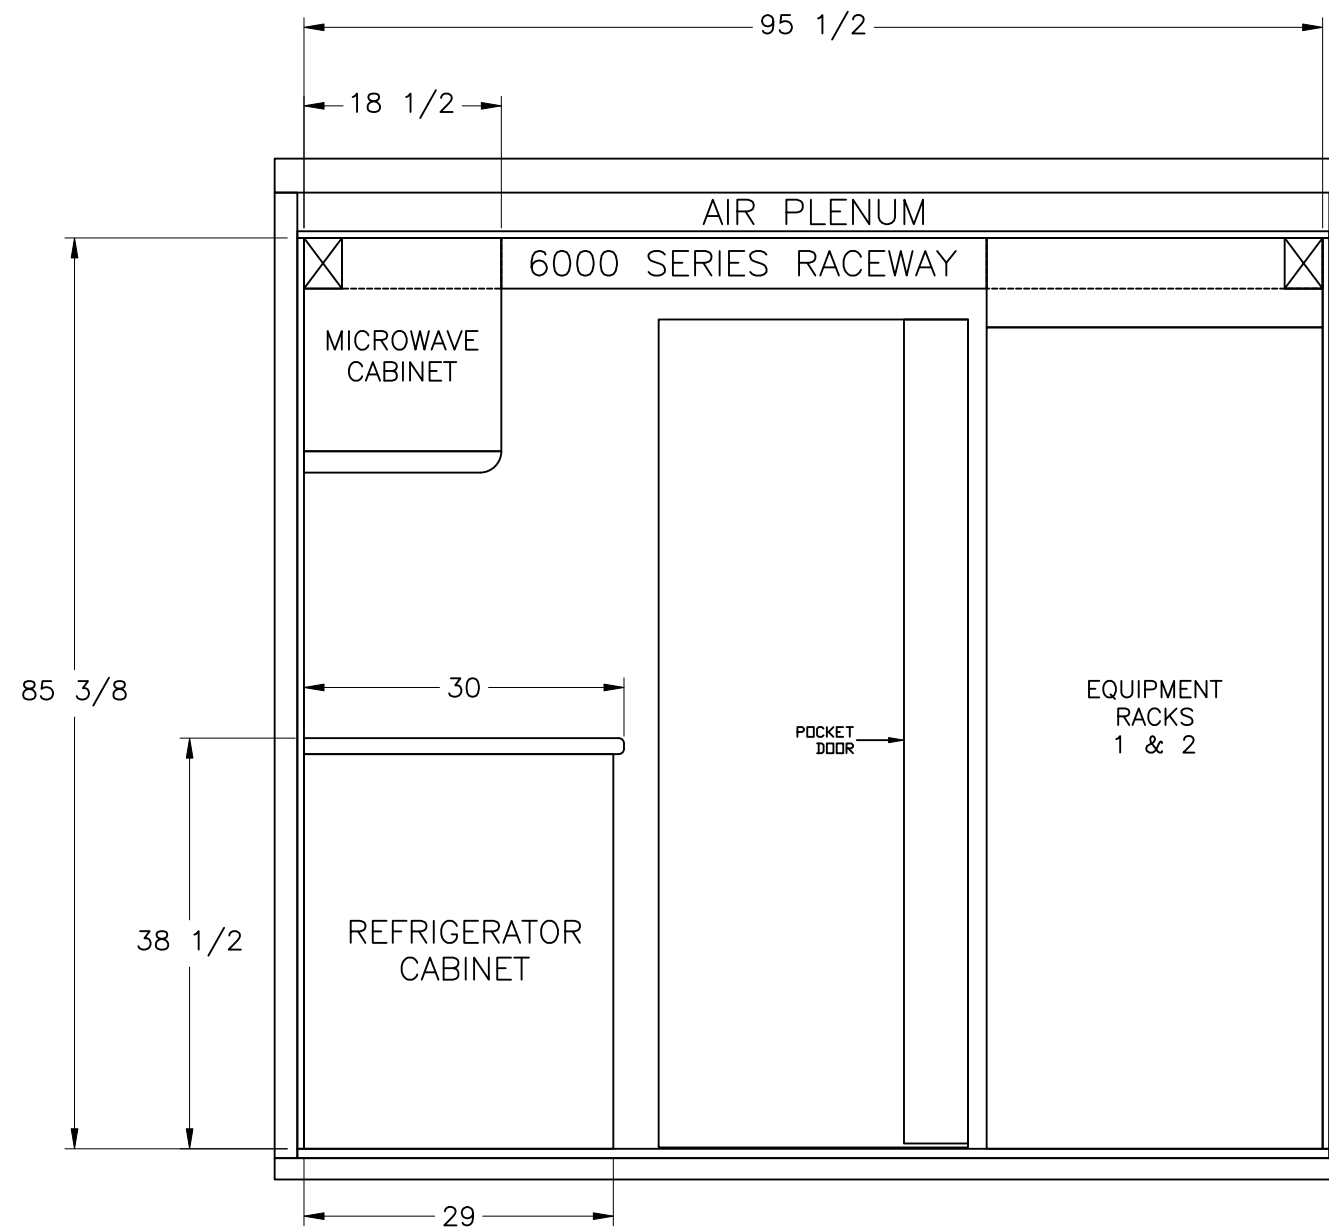


PARTITION WALL - REAR  
 REAR PARTITION WALL  
 VIEWED FROM MIDDLE OF VEHICLE  
 FACING THE REAR OF THE VEHICLE

← CURB SIDE

THIS DRAWING IS THE PROPERTY OF FRONTLINE COMMUNICATIONS CORPORATION. IT IS CONFIDENTIAL AND ALL RIGHTS ARE RESERVED. IT SHALL NOT BE REPRODUCED, COPIED, LENT, NOR USED FOR ANY PURPOSE OTHER THAN THAT FOR WHICH IT IS SPECIFICALLY FURNISHED.

DO NOT SCALE THIS DRAWING DIMENSIONS ARE IN INCHES UNLESS OTHERWISE SPECIFIED		MATERIAL <b>SEE NOTES</b>		<b>FRONTLINE COMMUNICATIONS</b> <small>12770 44th Street North          Clearwater, FL 33762-4713          (727) 573-0400          An Oshkosh Corporation Company FAX (727) 571-3295</small>	
TOLERANCES: ANGULAR: ± 1° BEND: ± 1" 2 PLACE DECIMAL ± .010 3 PLACE DECIMAL ± .005 FRACTIONS ± 1/16		FINISH <b>MILL FINISH</b>		<b>INTERIOR LAYOUT PARTITION - REAR</b>	
JOB NUMBER OR PRODUCT LINE <b>91995</b>		DRAWN BY <b>VJP</b>	DATE <b>5/24/24</b>	SIZE <b>B</b>	DWG NO. <b>91995-40710</b>
SHEET <b>2 OF 2</b>	SCALE <b>18</b>	CHECKED BY <b>CJM</b>	DATE <b>6/26/24</b>		

REVISIONS					
CHK DATE	CHK BY	DESCRIPTION	DATE	BY	REV
7/24/24	PJS	SHIFTED FRONT PIONEER LIGHT BACK	7/24/24	CJM	03

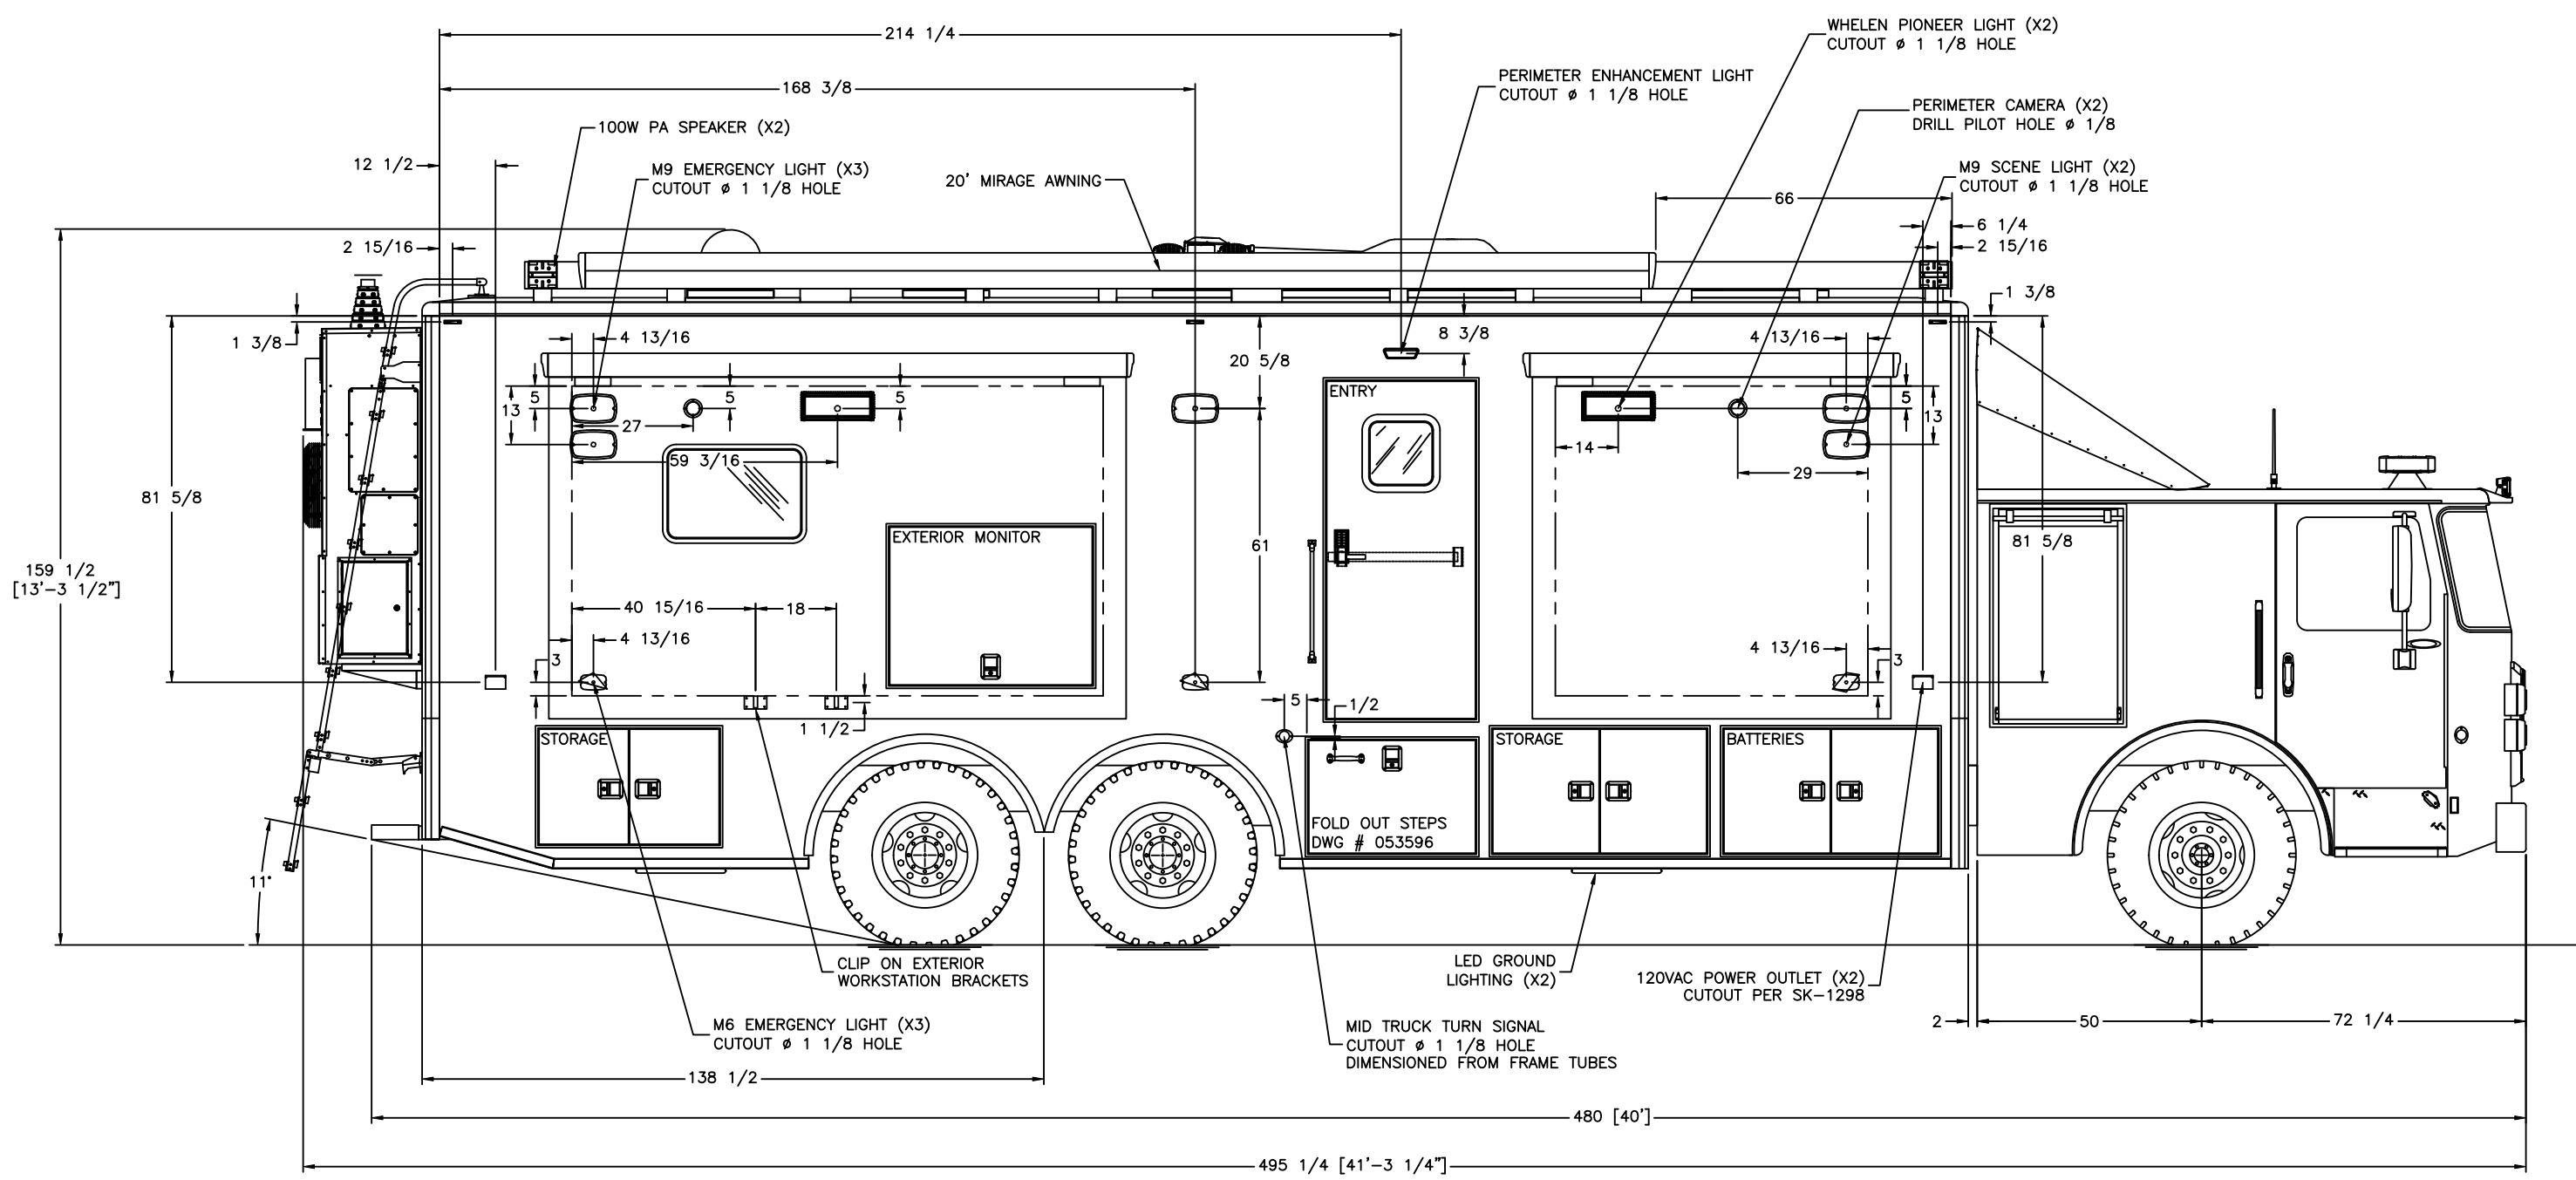


----- INSIDE EDGE OF FRAME TUBE


THIS DRAWING IS THE PROPERTY OF FRONTLINE COMMUNICATIONS CORPORATION. IT IS CONFIDENTIAL AND ALL RIGHTS ARE RESERVED. IT SHALL NOT BE REPRODUCED, COPIED, LENT, NOR USED FOR ANY PURPOSE OTHER THAN THAT FOR WHICH IT IS SPECIFICALLY FURNISHED.

DO NOT SCALE THIS DRAWING DIMENSIONS ARE IN INCHES UNLESS OTHERWISE SPECIFIED		MATERIAL <b>SEE NOTES</b>		<b>FRONTLINE COMMUNICATIONS</b> <small>12770 44th Street North Clearwater, FL 33762-4713 (727) 573-0400 FAX (727) 571-3295</small> A Division of Pierce Manufacturing Inc.	
TOLERANCES: ANGULAR: ± 1° BEND: ± 1° 2 PLACE DECIMAL ± .010 3 PLACE DECIMAL ± .005 FRACTIONS ± 1/16		FINISH <b>MILL FINISH</b>		<b>EXTERIOR LAYOUT CURB SIDE</b>	
JOB NUMBER OR PRODUCT LINE <b>91995</b>		DRAWN BY <b>CJM</b>	DATE <b>5/9/24</b>		
SHEET <b>1 OF 1</b>		SCALE <b>40</b>	CHECKED BY <b>MRS</b>	DATE <b>5/9/24</b>	SIZE <b>B</b>
				DWG NO. <b>91995-50200</b>	

REVISIONS					
CHK DATE	CHK BY	DESCRIPTION	DATE	BY	REV
7/24/24	PJS	SHIFTED FRONT PIONEER LIGHT BACK	7/24/24	CJM	03

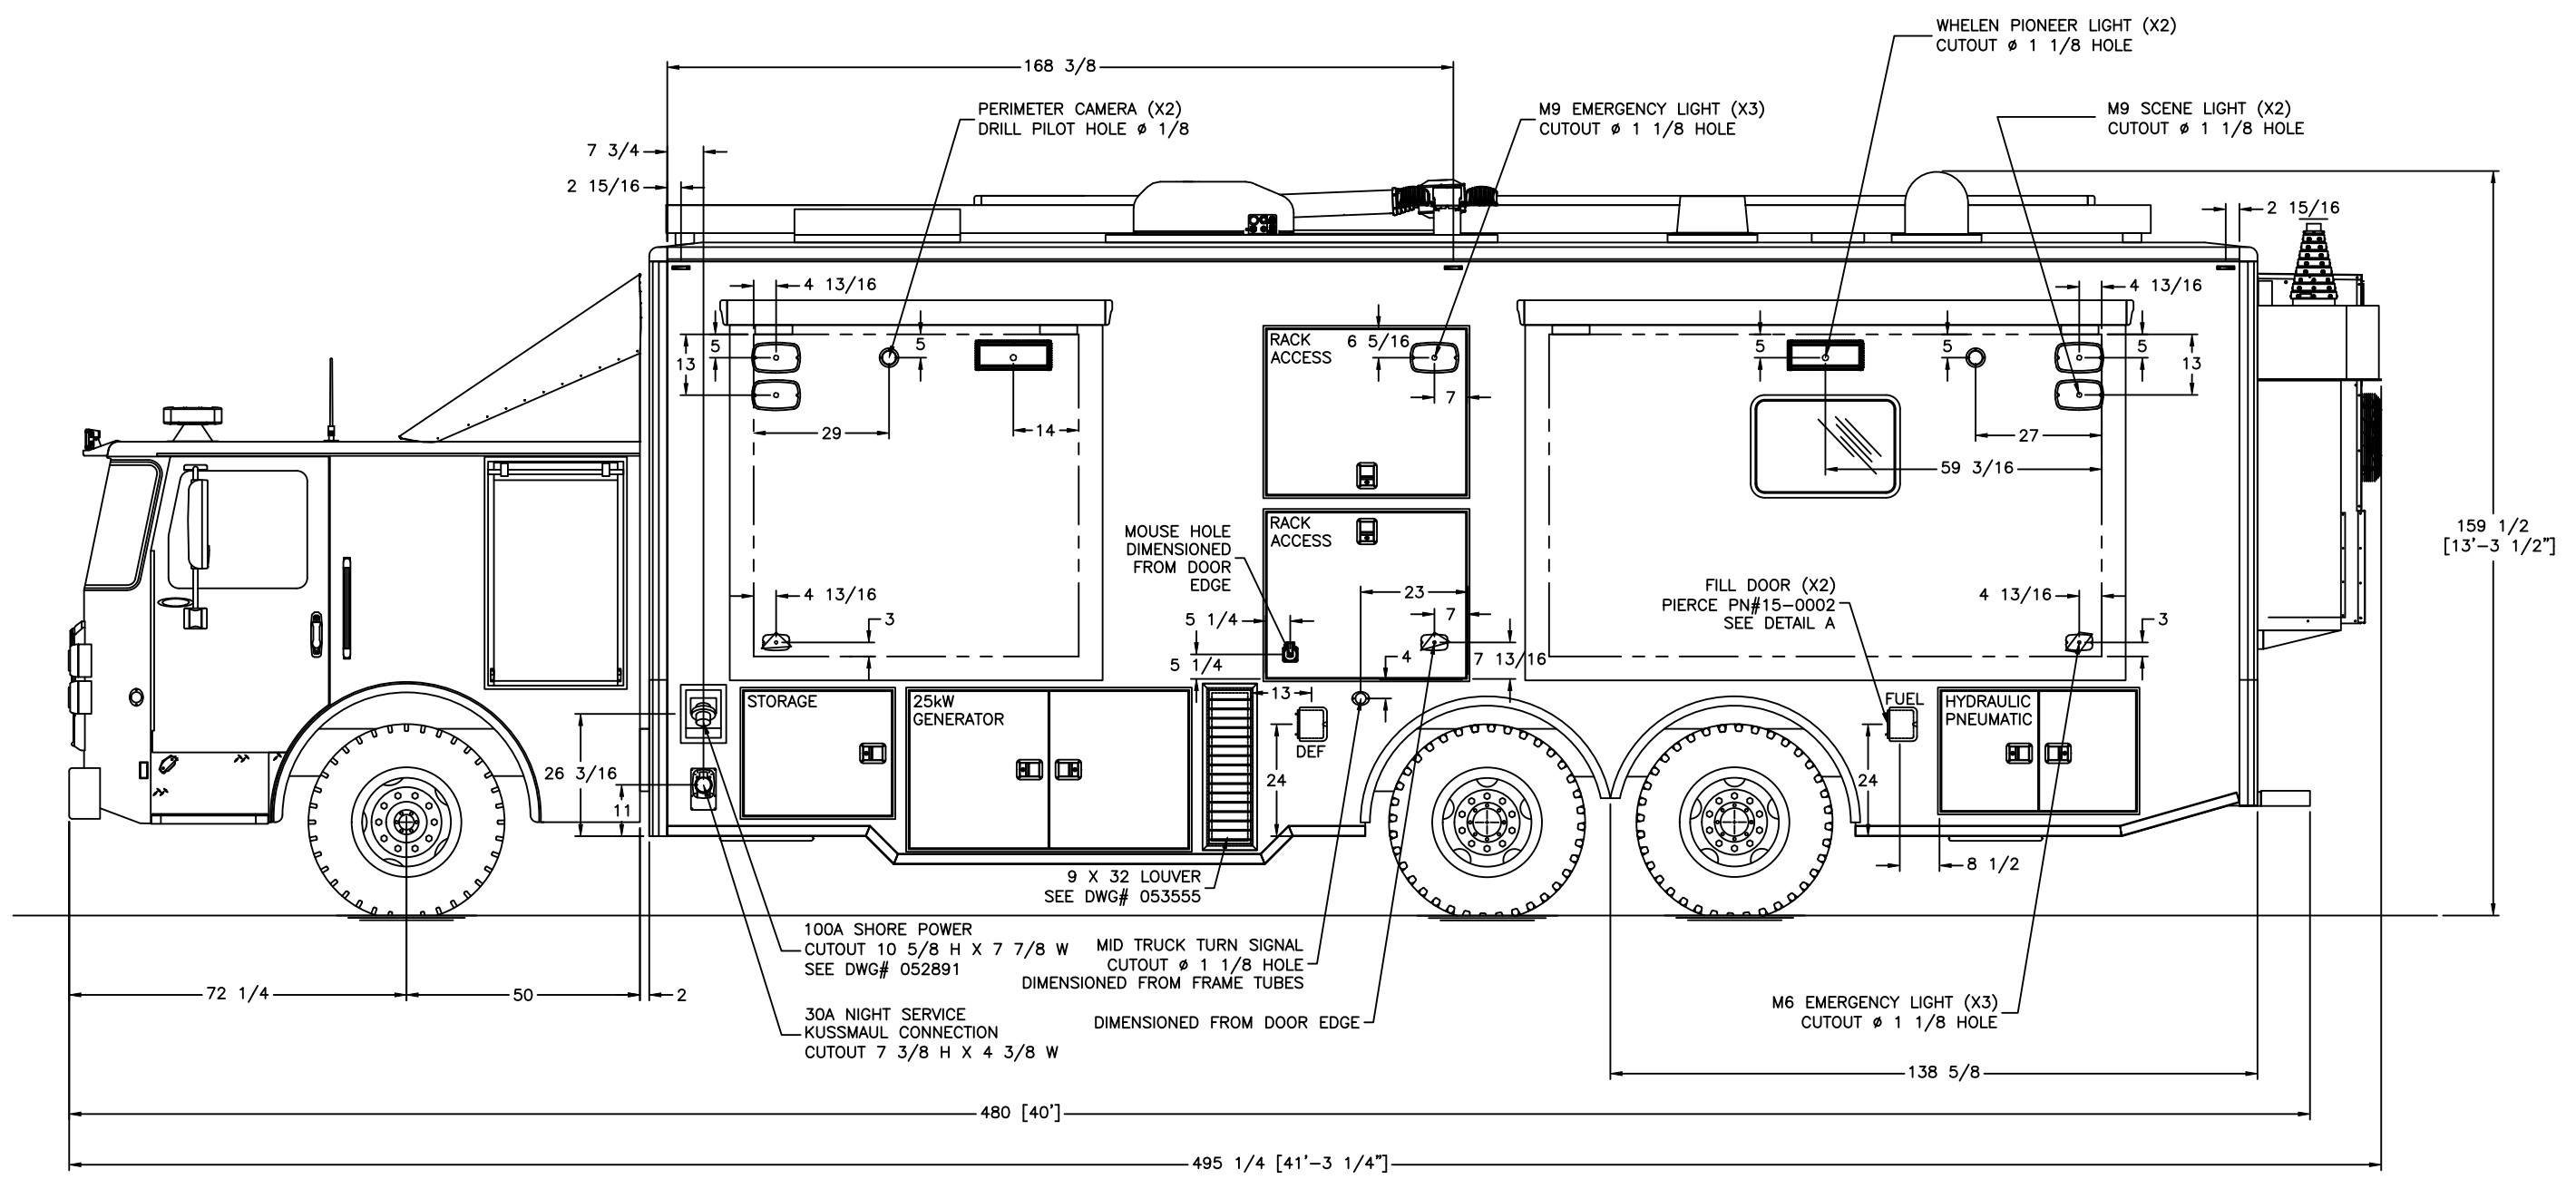

NOTE: DEF AND FUEL CUTOUTS DIMENSIONED FROM FRAME TUBES

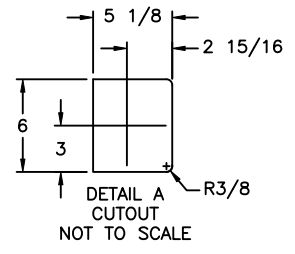


----- INSIDE EDGE OF FRAME TUBE

THIS DRAWING IS THE PROPERTY OF FRONTLINE COMMUNICATIONS CORPORATION. IT IS CONFIDENTIAL AND ALL RIGHTS ARE RESERVED. IT SHALL NOT BE REPRODUCED, COPIED, LENT, NOR USED FOR ANY PURPOSE OTHER THAN THAT FOR WHICH IT IS SPECIFICALLY FURNISHED.

DO NOT SCALE THIS DRAWING DIMENSIONS ARE IN INCHES UNLESS OTHERWISE SPECIFIED		MATERIAL <b>SEE NOTES</b>		FRONTLINE COMMUNICATIONS 12770 44th Street North Clearwater, FL 33762-4713 (727) 573-0400 FAX (727) 571-3295	
TOLERANCES: ANGULAR: $\pm$ 1° BEND: $\pm$ 1° 2 PLACE DECIMAL $\pm$ .010 3 PLACE DECIMAL $\pm$ .005 FRACTIONS $\pm$ 1/16		FINISH <b>MILL FINISH</b>		<b>EXTERIOR LAYOUT STREET SIDE</b>	
JOB NUMBER OR PRODUCT LINE <b>91995</b>		DRAWN BY <b>CJM</b>	DATE <b>5/9/24</b>		
SHEET <b>1 OF 1</b>	SCALE <b>40</b>	CHECKED BY <b>MRS</b>	DATE <b>5/9/24</b>	SIZE <b>B</b>	DWG NO. <b>91995-50300</b>

REVISIONS

CHK DATE	CHK BY	DESCRIPTION	DATE	BY	REV
5/9/24	MRS	ENGINEERING RELEASE	5/9/24	CJM	00

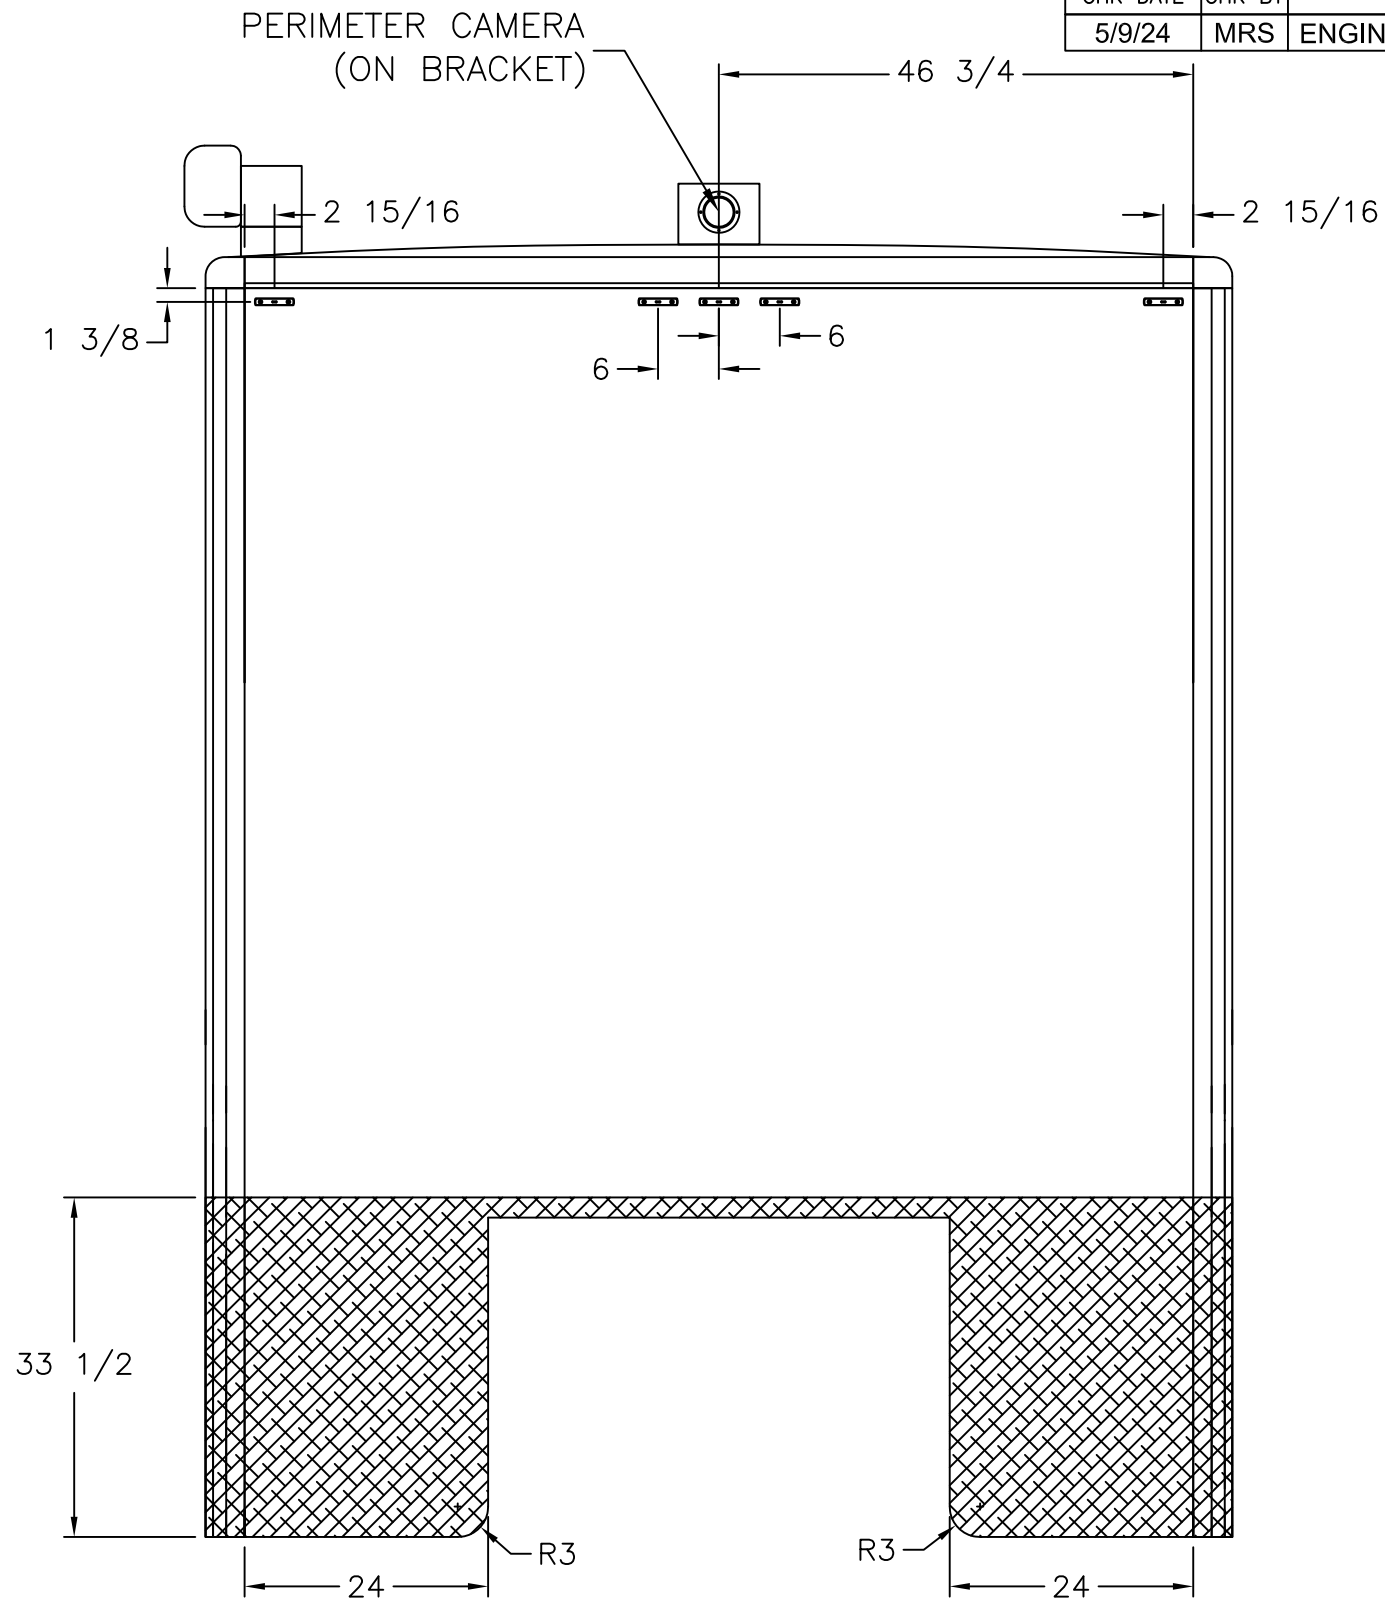

THIS DRAWING IS THE PROPERTY OF FRONTLINE COMMUNICATIONS CORPORATION. IT IS CONFIDENTIAL AND ALL RIGHTS ARE RESERVED. IT SHALL NOT BE REPRODUCED, COPIED, LENT, NOR USED FOR ANY PURPOSE OTHER THAN THAT FOR WHICH IT IS SPECIFICALLY FURNISHED.

DO NOT SCALE THIS DRAWING  
DIMENSIONS ARE IN INCHES  
UNLESS OTHERWISE SPECIFIED

TOLERANCES:  
ANGULAR: ± 1° BEND: ± 1°  
2 PLACE DECIMAL ± .010  
3 PLACE DECIMAL ± .005  
FRACTIONS ± 1/16

MATERIAL  
**SEE NOTES**

FINISH  
**MILL FINISH**

**FRONTLINE COMMUNICATIONS**  
A Division of Pierce Manufacturing Inc.

12770 44th Street North  
Clearwater, FL 33762-4713  
(727) 573-0400  
FAX (727) 571-3295

JOB NUMBER OR PRODUCT LINE  
**91995**

SHEET 1 OF 1 SCALE 20

DRAWN BY  
**CJM**

CHECKED BY  
**MRS**

DATE  
**5/9/24**


DATE  
**5/9/24**

**EXTERIOR LAYOUT FRONT**

SIZE **B** DWG NO. **91995-50400**

REVISIONS

CHK DATE	CHK BY	DESCRIPTION	DATE	BY	REV
6/29/23	MRS	ENGINEERING RELEASE	6/26/23	CJM	00

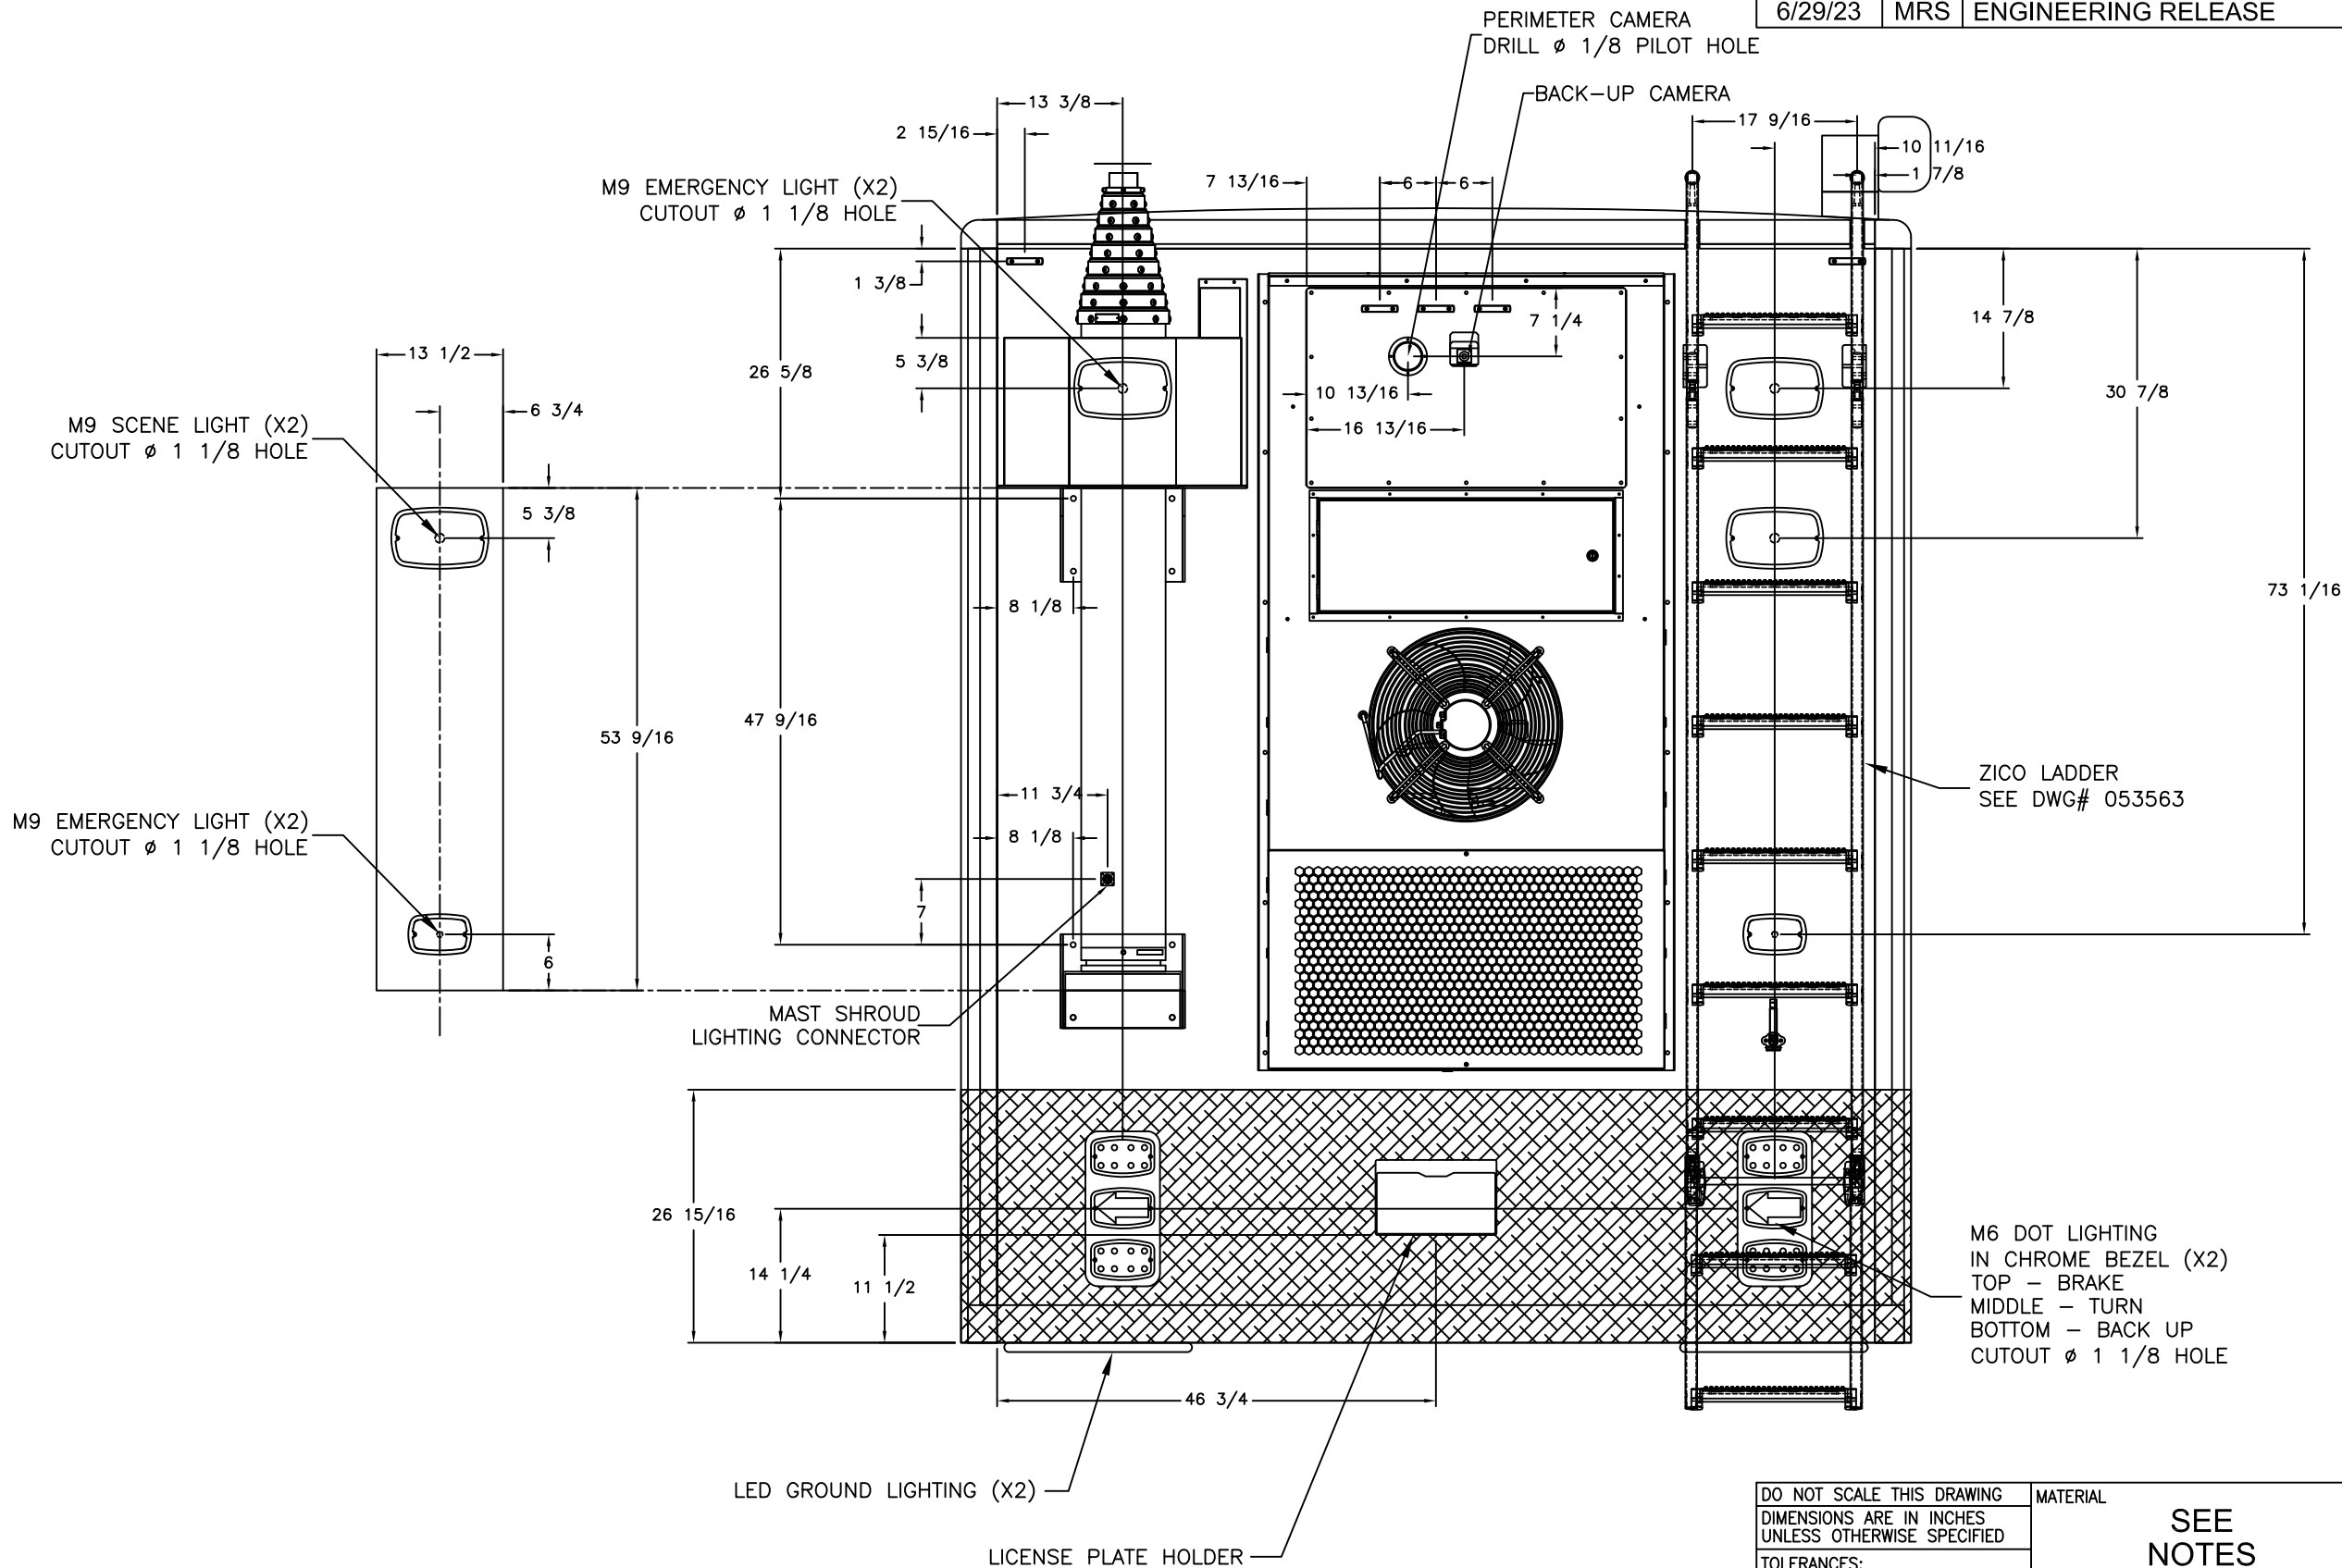

THIS DRAWING IS THE PROPERTY OF FRONTLINE COMMUNICATIONS CORPORATION. IT IS CONFIDENTIAL AND ALL RIGHTS ARE RESERVED. IT SHALL NOT BE REPRODUCED, COPIED, LENT, NOR USED FOR ANY PURPOSE OTHER THAN THAT FOR WHICH IT IS SPECIFICALLY FURNISHED.

DO NOT SCALE THIS DRAWING  
 DIMENSIONS ARE IN INCHES  
 UNLESS OTHERWISE SPECIFIED  
 TOLERANCES:  
 ANGULAR: ± 1° BEND: ± 1°  
 2 PLACE DECIMAL ± .010  
 3 PLACE DECIMAL ± .005  
 FRACTIONS ± 1/16

MATERIAL  
**SEE NOTES**  
 FINISH  
**MILL FINISH**


JOB NUMBER OR PRODUCT LINE  
**91986**  
 SHEET  
**1 OF 1**  
 SCALE  
**20**

DRAWN BY  
**CJM**  
 DATE  
**6/26/23**  
 CHECKED BY  
**MRS**  
 DATE  
**6/29/23**

**FRONTLINE COMMUNICATIONS**  
 A Division of Pierce Manufacturing Inc.  
 12770 44th Street North  
 Clearwater, FL 33762-4713  
 (727) 573-0400  
 FAX (727) 571-3295

**EXTERIOR LAYOUT REAR**  
 SIZE **B** DWG NO. **91986-50500**

REVISIONS					
CHK DATE	CHK BY	DESCRIPTION	DATE	BY	REV
8/19/24	JAB	ADDED L-BRACKET DETAIL (SHT 1)	8/19/24	CJM	01

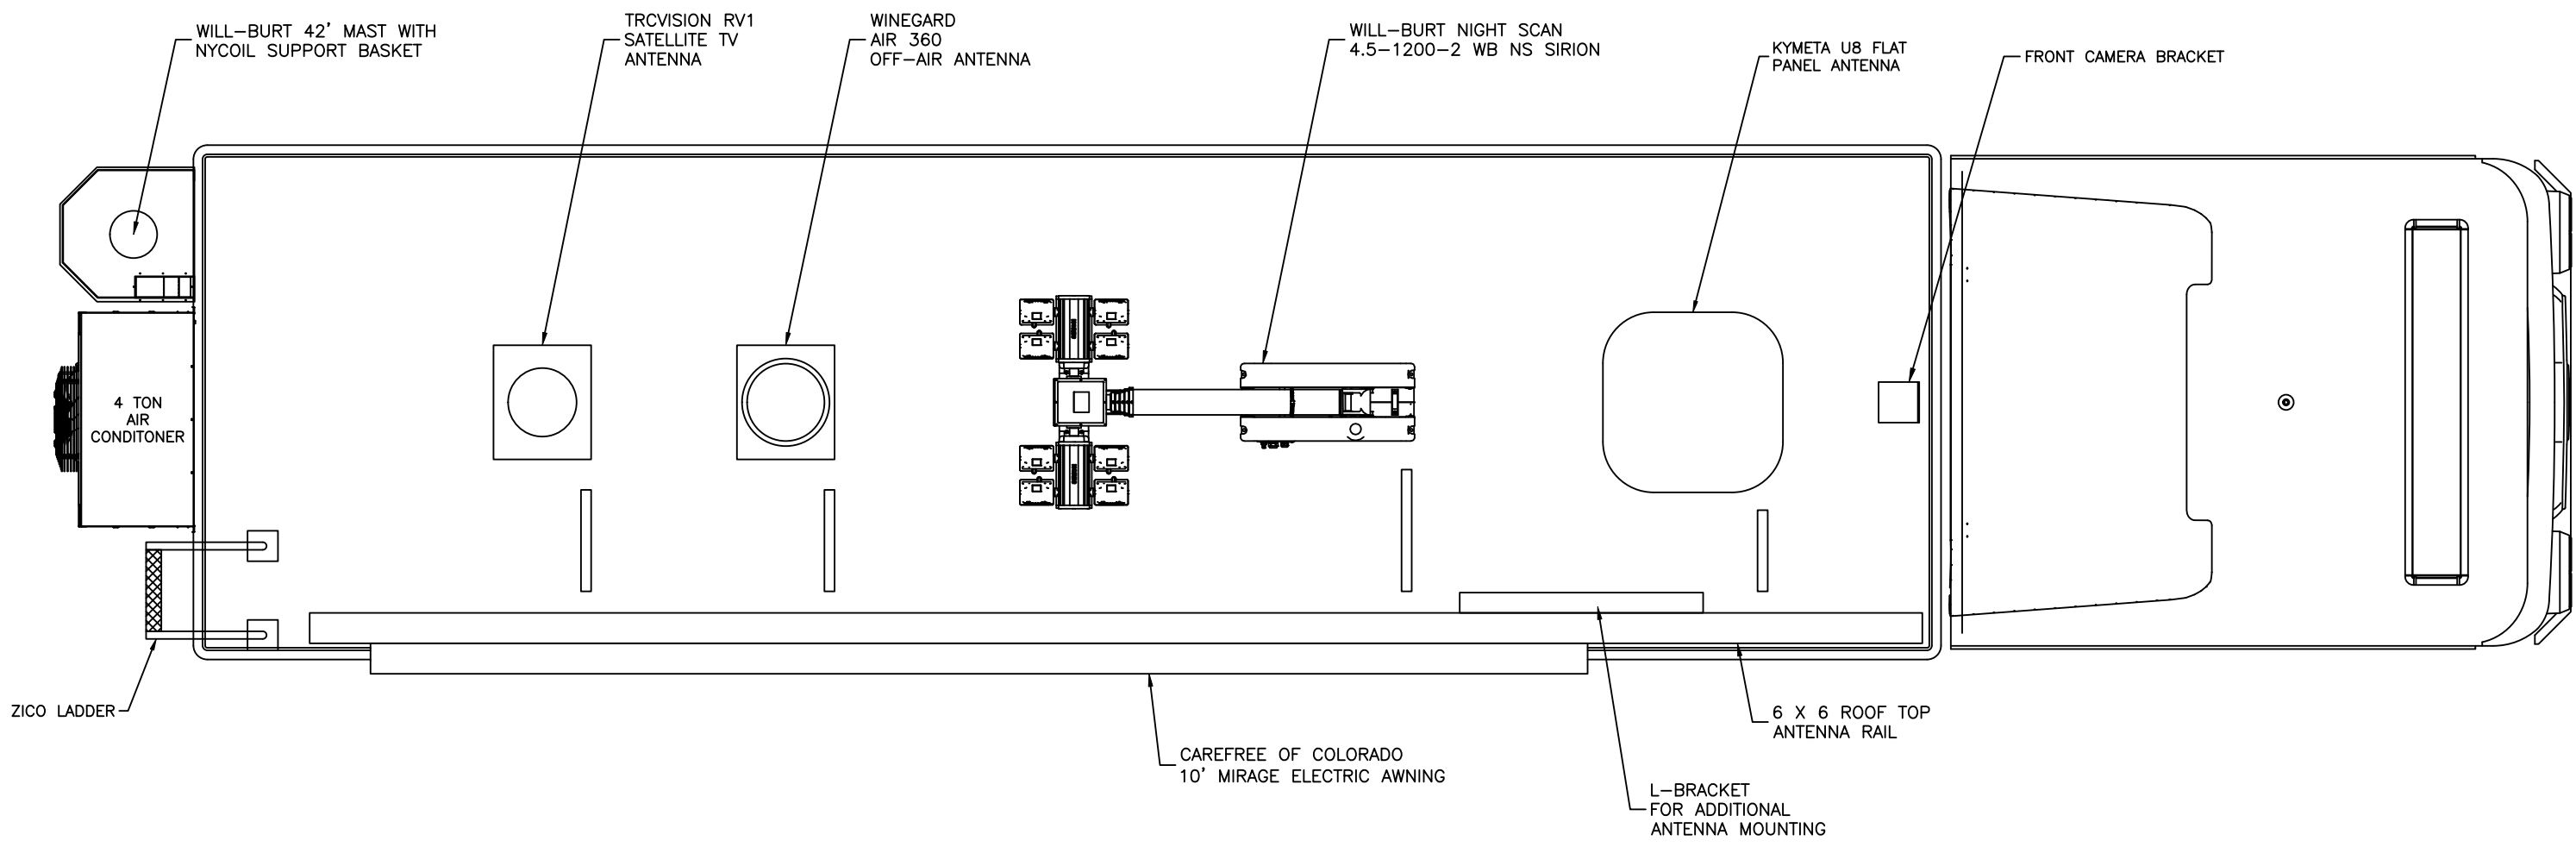

THIS DRAWING IS THE PROPERTY OF FRONTLINE COMMUNICATIONS CORPORATION. IT IS CONFIDENTIAL AND ALL RIGHTS ARE RESERVED. IT SHALL NOT BE REPRODUCED, COPIED, LENT, NOR USED FOR ANY PURPOSE OTHER THAN THAT FOR WHICH IT IS SPECIFICALLY FURNISHED.

DO NOT SCALE THIS DRAWING DIMENSIONS ARE IN INCHES UNLESS OTHERWISE SPECIFIED		MATERIAL <b>SEE NOTES</b>		<b>FRONTLINE COMMUNICATIONS</b> <small>A Division of Pierce Manufacturing Inc.</small> 12770 44th Street North Clearwater, FL 33762-4713 (727) 573-0400 FAX (727) 571-3295	
TOLERANCES: ANGULAR: ± 1° BEND: ± 1" 2 PLACE DECIMAL ± .010 3 PLACE DECIMAL ± .005 FRACTIONS ± 1/16		FINISH <b>MILL FINISH</b>		<b>EXTERIOR LAYOUT ROOF</b>	
JOB NUMBER OR PRODUCT LINE <b>91995</b>		DRAWN BY <b>CJM</b>	DATE <b>5/9/24</b>		
SHEET <b>1 OF 2</b>	SCALE <b>35</b>	CHECKED BY <b>MRS</b>	DATE <b>5/9/24</b>	SIZE <b>B</b>	DWG NO. <b>91995-50600</b>